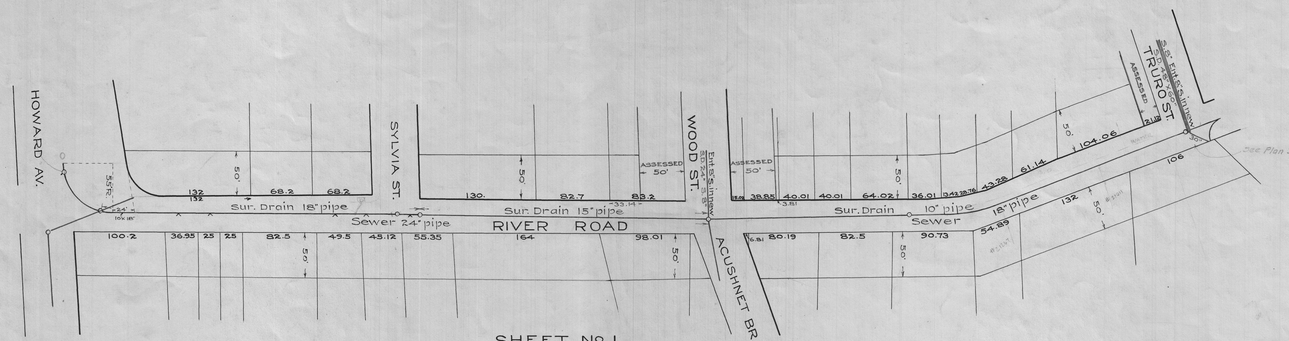


SHEET No 1

RIVER RD. SEWER AND SUR. DRAIN

HOWARD AVE. to TARKILN HILL RD.

SCALE

Horizontal; 1in. = 60ft. Vertical; 1in. = 6ft.

Ordered	Sept. 15, 1922
Construction Commenced	Oct. 13, 1922
Construction Completed	May 9, 1923
Average Cut	10.18 feet
Ledge Excavated	234.6 CuYds.
Cost	$ 44930.46
Amount Assessed	$ 6866.34

CARD

George H. Hoyt

CITY ENGINEER

