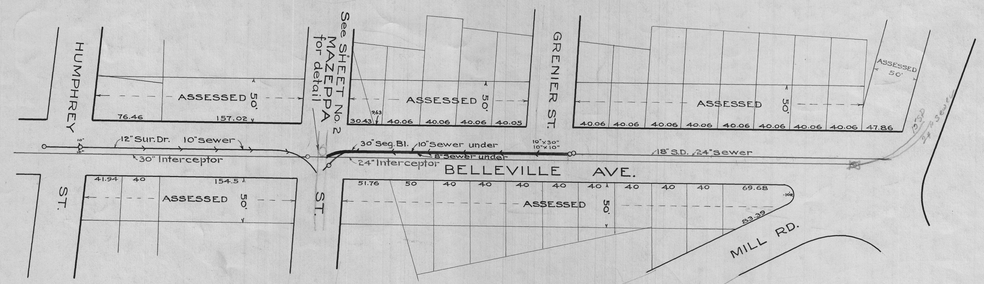

SHEET NO. 3.

TARKILN HILL SYSTEM FIRST SECTION

SECTION
MAZEPPA to GRENIER
LOOKING NORTH

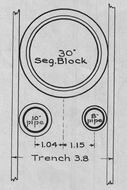

Scale; 1"-2'