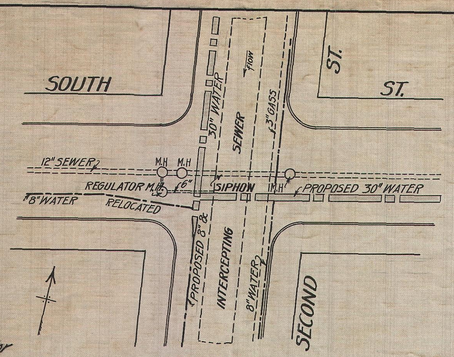

PLAN
SCALE 1 inch = 20 feet

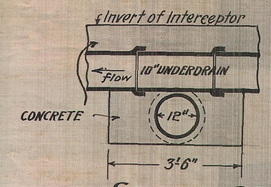

SECTION C-C

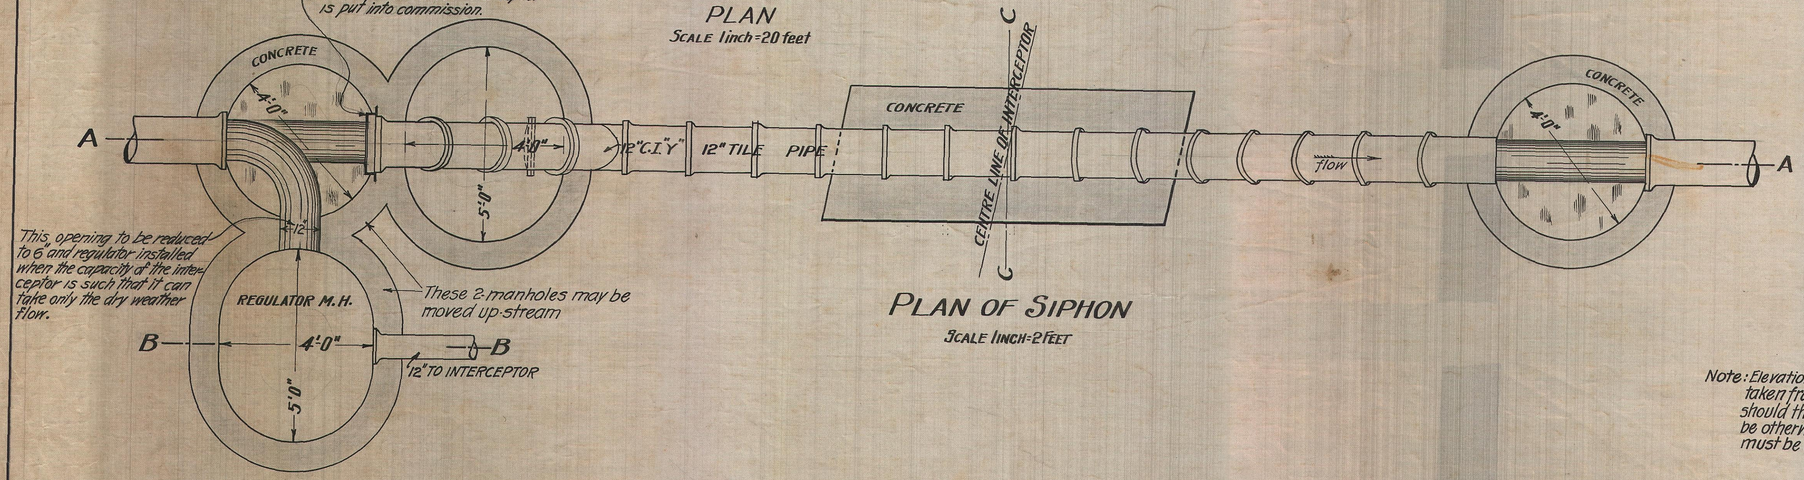

PLAN OF SIPHON
SCALE 1 inch = 2 FEET

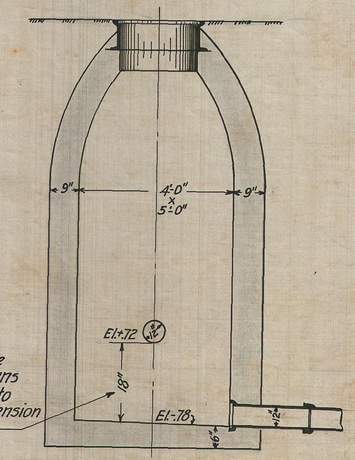

Note: Elevations shown are taken from office plans should they be found to be otherwise, this dimension must be maintained

SECTION B-B
REGULATING M.H.
1 inch = 2 feet

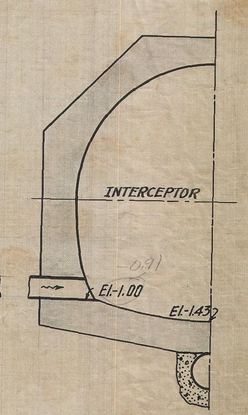

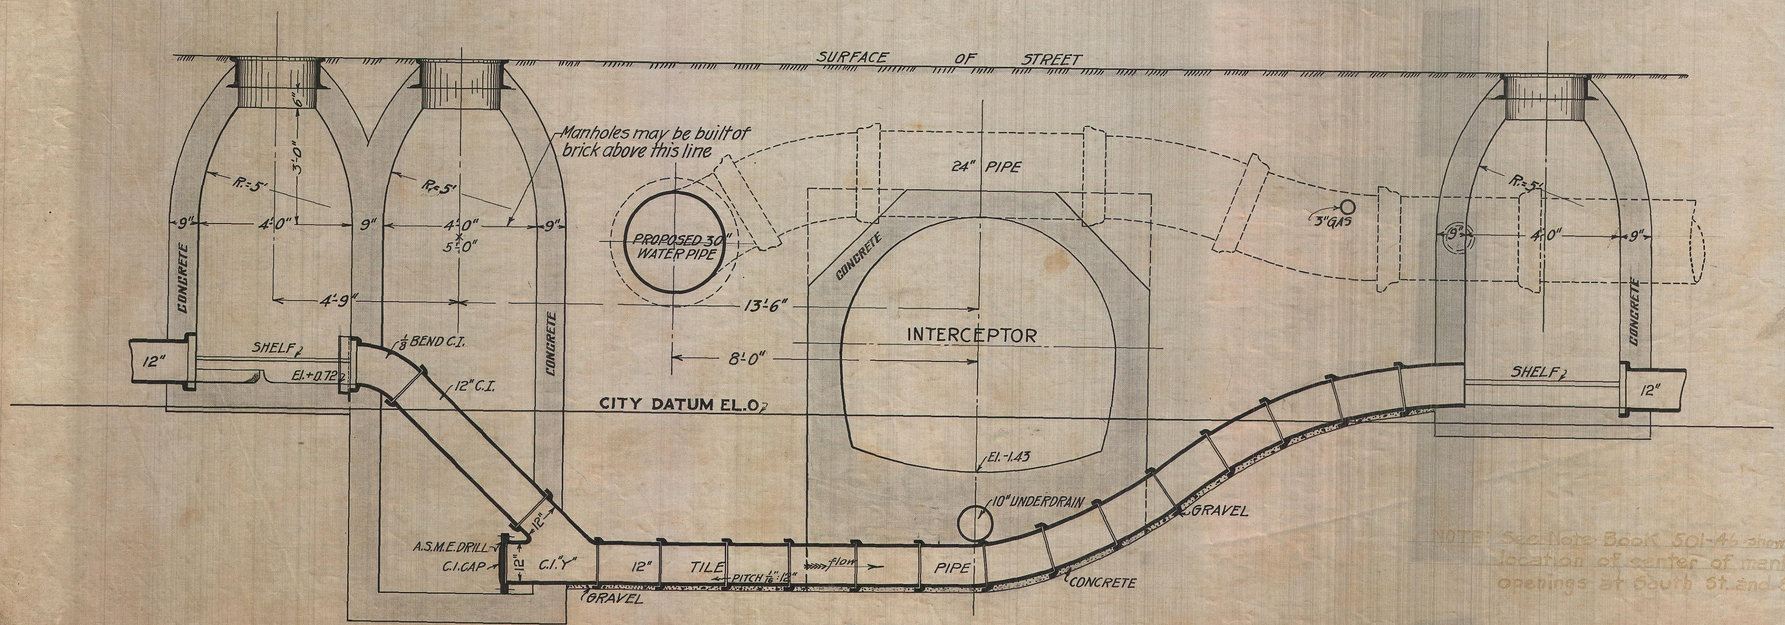

SECTION ON LINE A-A

CITY OF NEW BEDFORD
INTERCEPTING SEWER SYSTEM
~~DETAILS OF~~
SIPHON AND 6"- CONNECTION
AT SOUTH ST.
August, 1913

William F. Williams
CONSULTING ENGINEER

SCALES AS NOTED

NOTE: See Note Book 501-46 showing location of center of manhole openings at South St. and Second St.

Case A-8184.