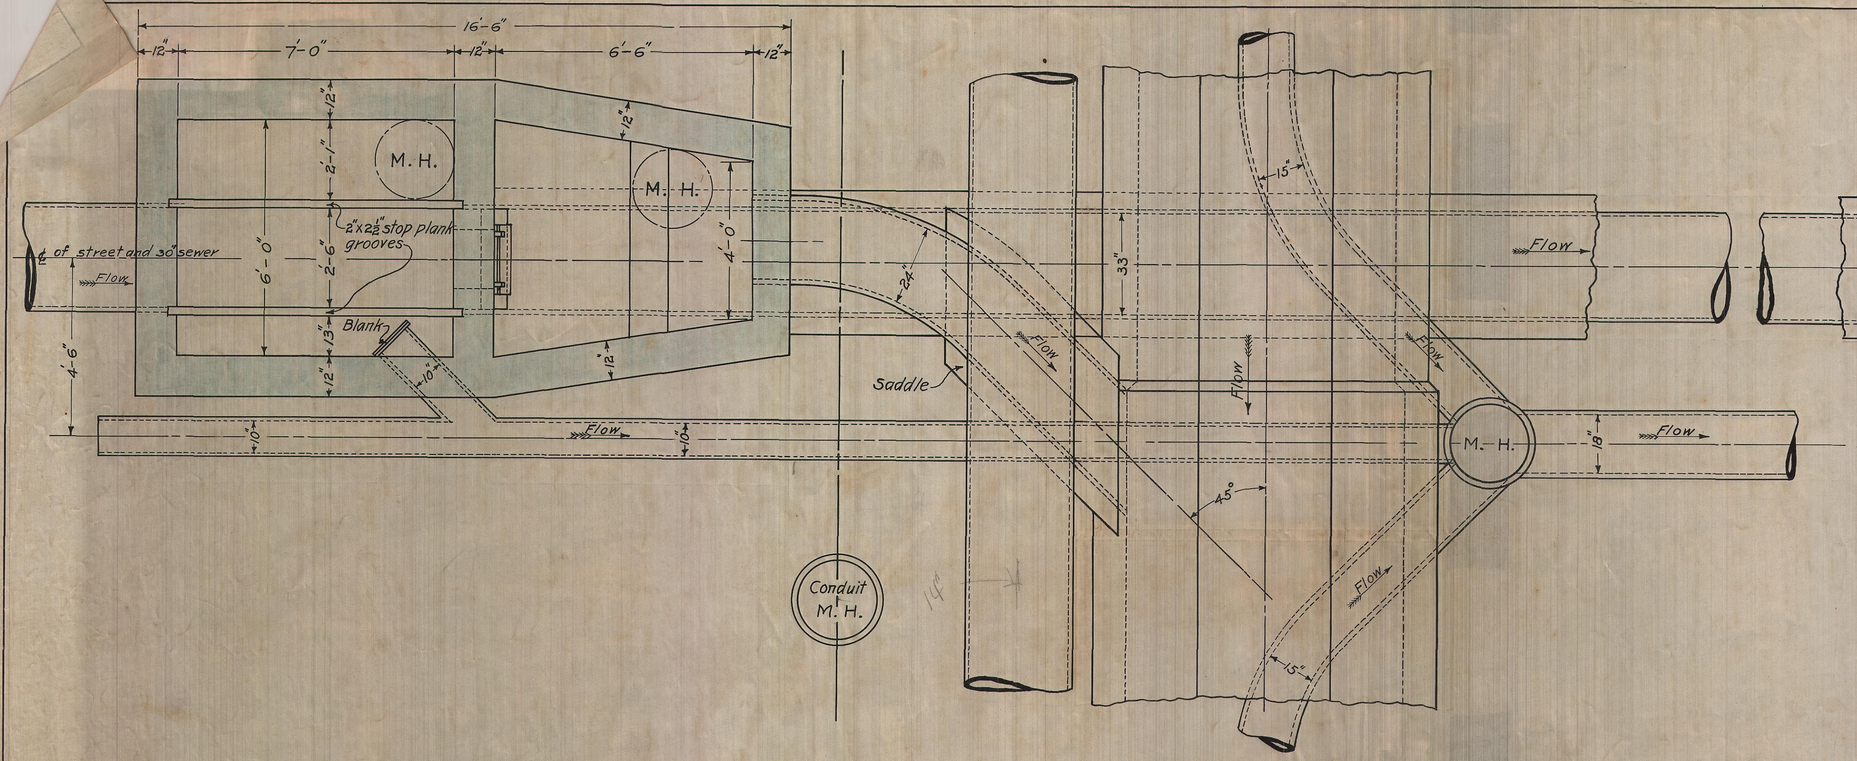

Plan.
Scale:- ½"=1'-0".

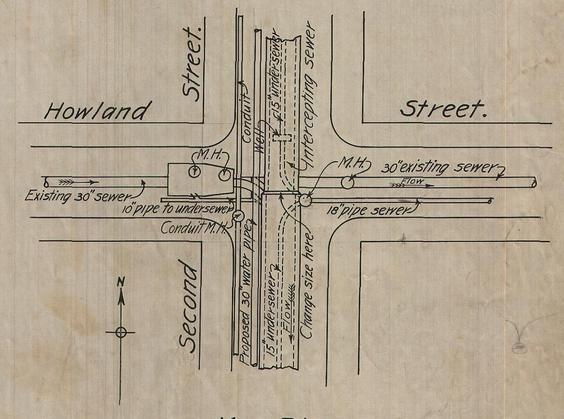

Key Plan.
Scale:- 1"=20'-0".

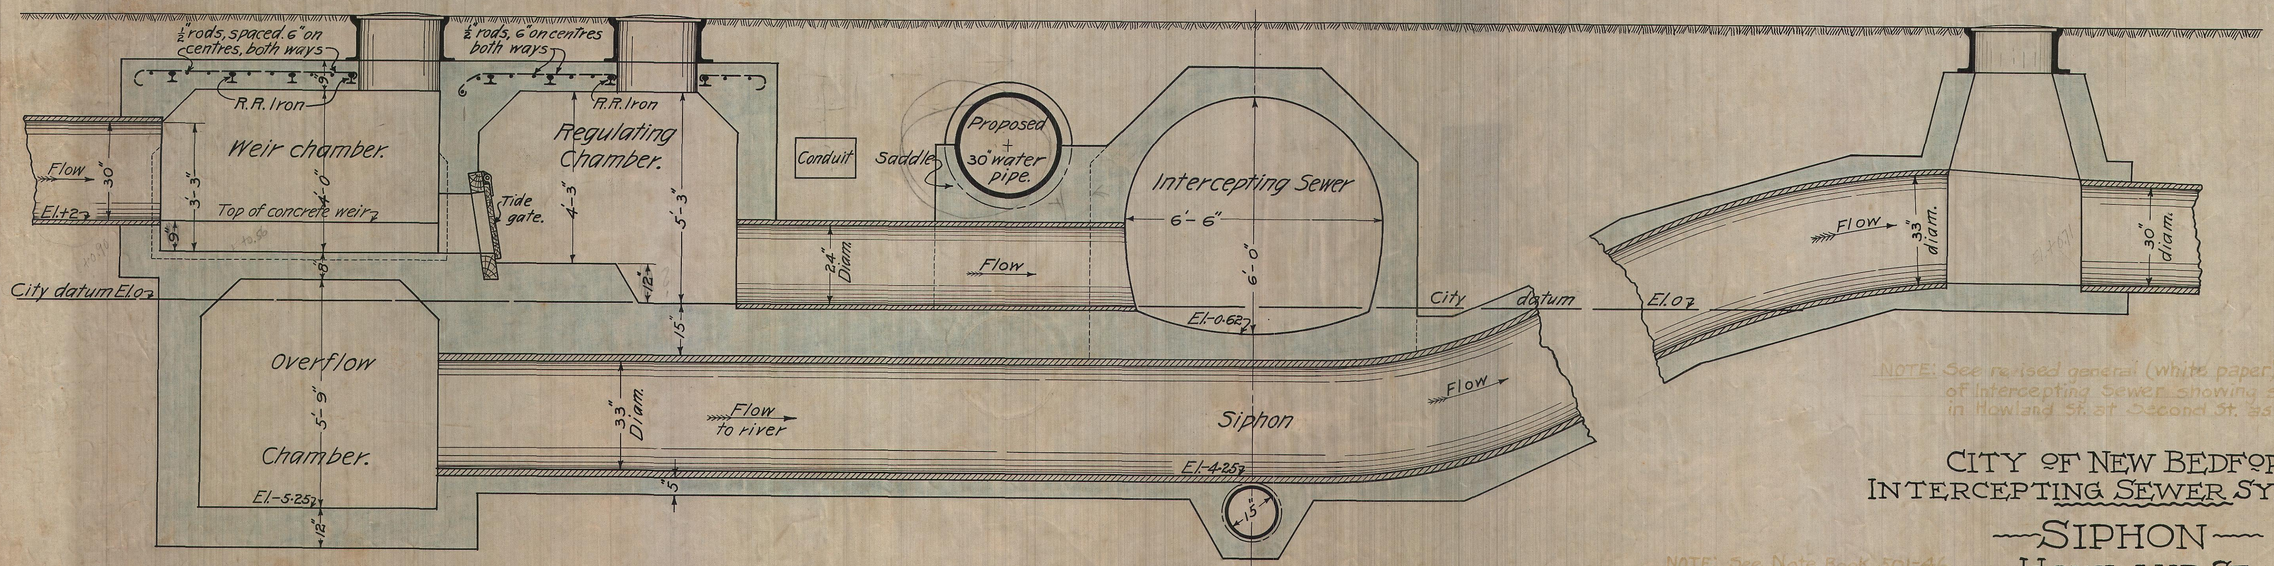

Sectional elevation.
Scale:- ½"=1'-0".

NOTE: See revised general (white paper) drawings of Intercepting Sewer showing special structure in Howland St. at Second St. as constructed.

NOTE: See Note Book 501-46 showing location of center of manhole openings at Second St. and Howland St.

CITY OF NEW BEDFORD
INTERCEPTING SEWER SYSTEM

SIPHON
HOWLAND ST.
March 1914.
Scales as noted.

Case A-8183