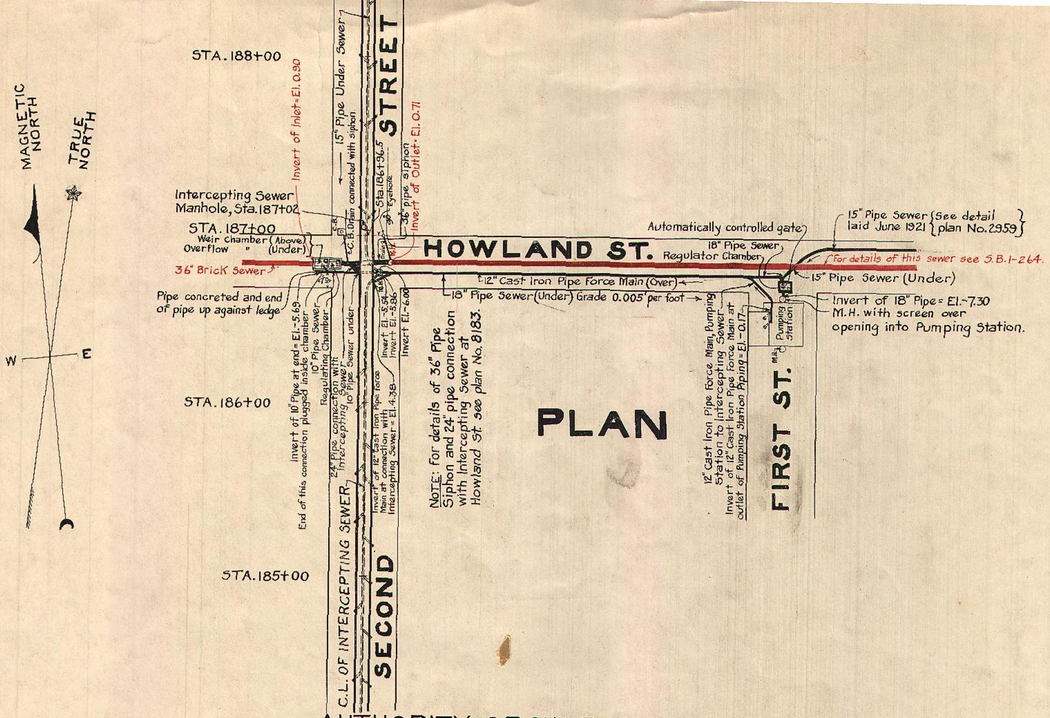

BRANCHES					
18 PIPE SEWER					
W. of W. Line of First St.					
S.	Remarks.				
27.7	Branch under existing 6" drain. El. 1.3 = top of drain.				
33.3	"	"	" 6"	"	El. 3.5 = " " "
37.8	"	"	" 6"	"	El. 2.6 = " " "
64.4	"	"	" 6"	"	El. 0.8 = " " "
92.5	"	"	" 6"	"	El. 1.0 = " " "
121.2	"	"	" 4"	"	El. 1.7 = " " "
127.7	"	"	" 4"	"	El. 1.9 = " " "
152.1	"	"	" 6"	"	El. 2.4 = " " "
178.6	"	"	" 6"	"	El. 1.6 = " " "
214.0	"	"	" 6"	"	
15" Branch pointing easterly on c. line of First St. and 4' north of S. line of Howland St.					

AUTHORITY OF CHAP. 474, ACTS OF 1910.

SEWAGE DISPOSAL
NEW BEDFORD, MASS.
INTERCEPTING SEWER.
18" PIPE SEWER
AND
12" C.I. PIPE FORCE MAIN
IN
HOWLAND ST. {FIRST ST. TO SECOND ST.}

SCALES: PLAN
PROFILE {Hor. 1" = 40' Ver. 1" = 4'}

SEPT. 1920.

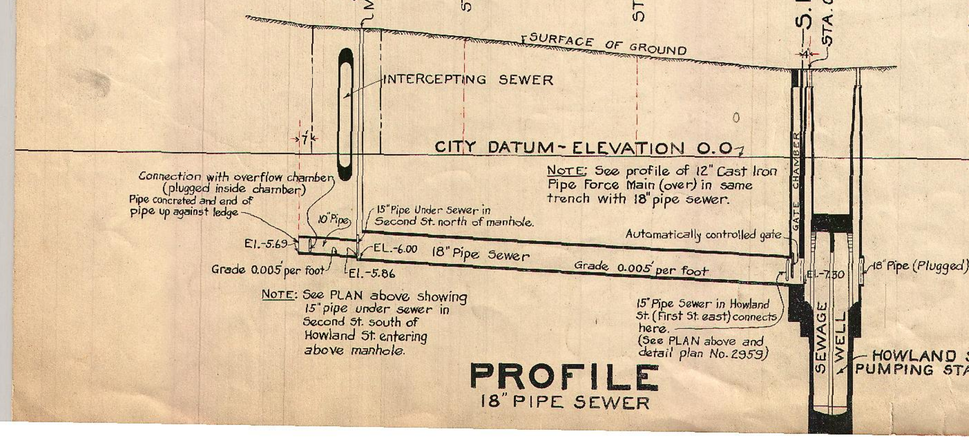

PROFILE
18" PIPE SEWER

Note: See N.B. 502-28 for levels on ledge at Howland St. Pumping Station.

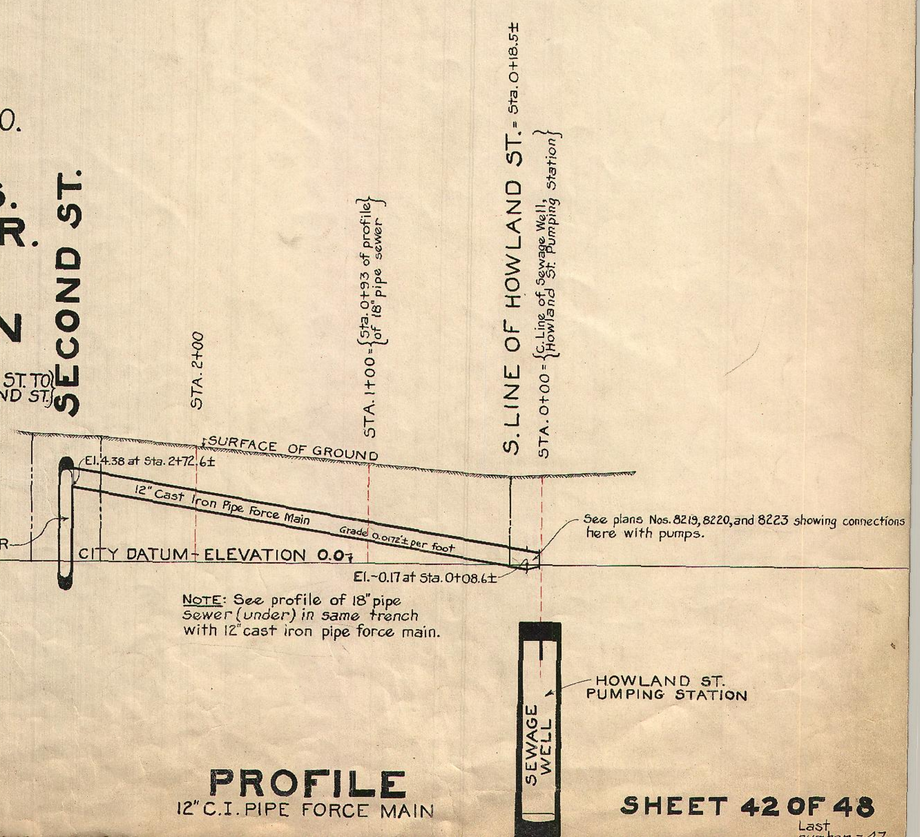

PROFILE
12" C.I. PIPE FORCE MAIN

SHEET 42 OF 48

Last