2001

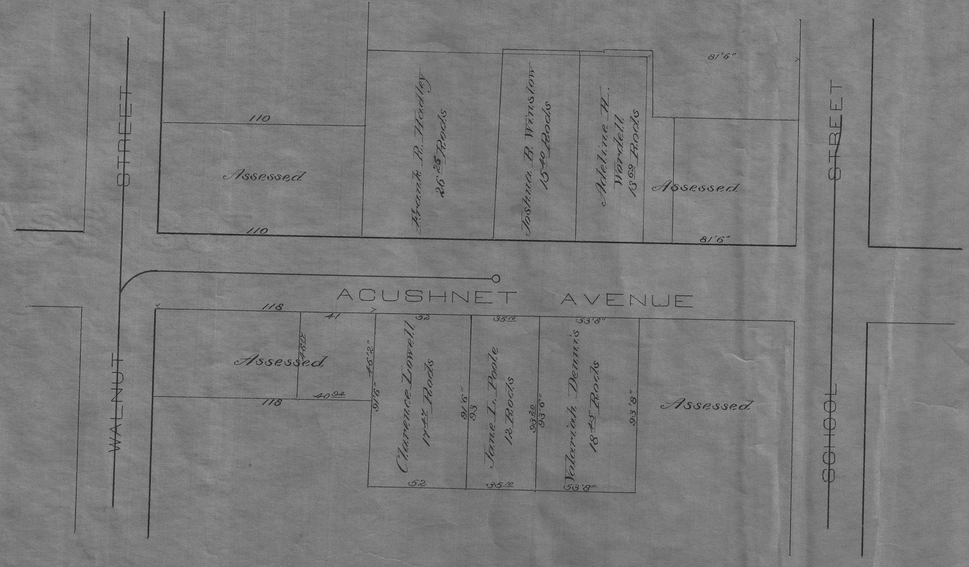

MANHOLE

180.30 n. of n. line of Walnut Street

LENGTH

204.32 feet of 10 inch glazed pipe

SCALE

1 inch equals 50 feet

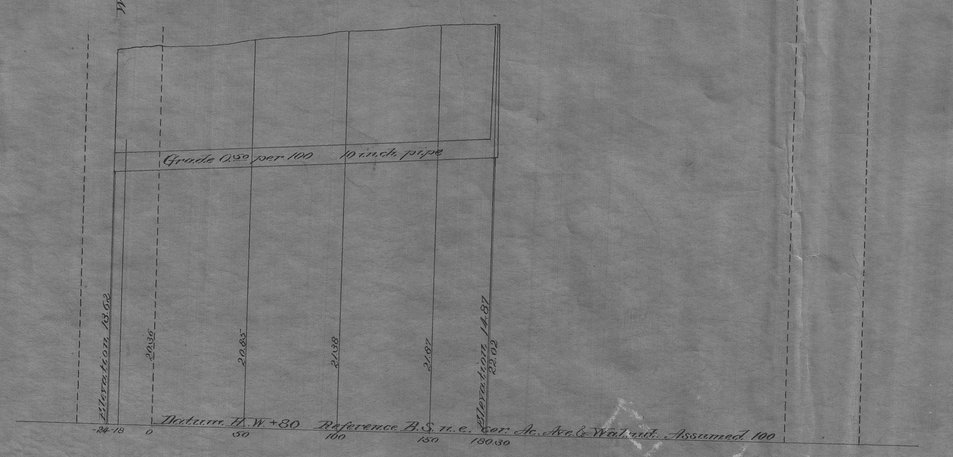

2001