


MATCH LINE - SEE FIG. D

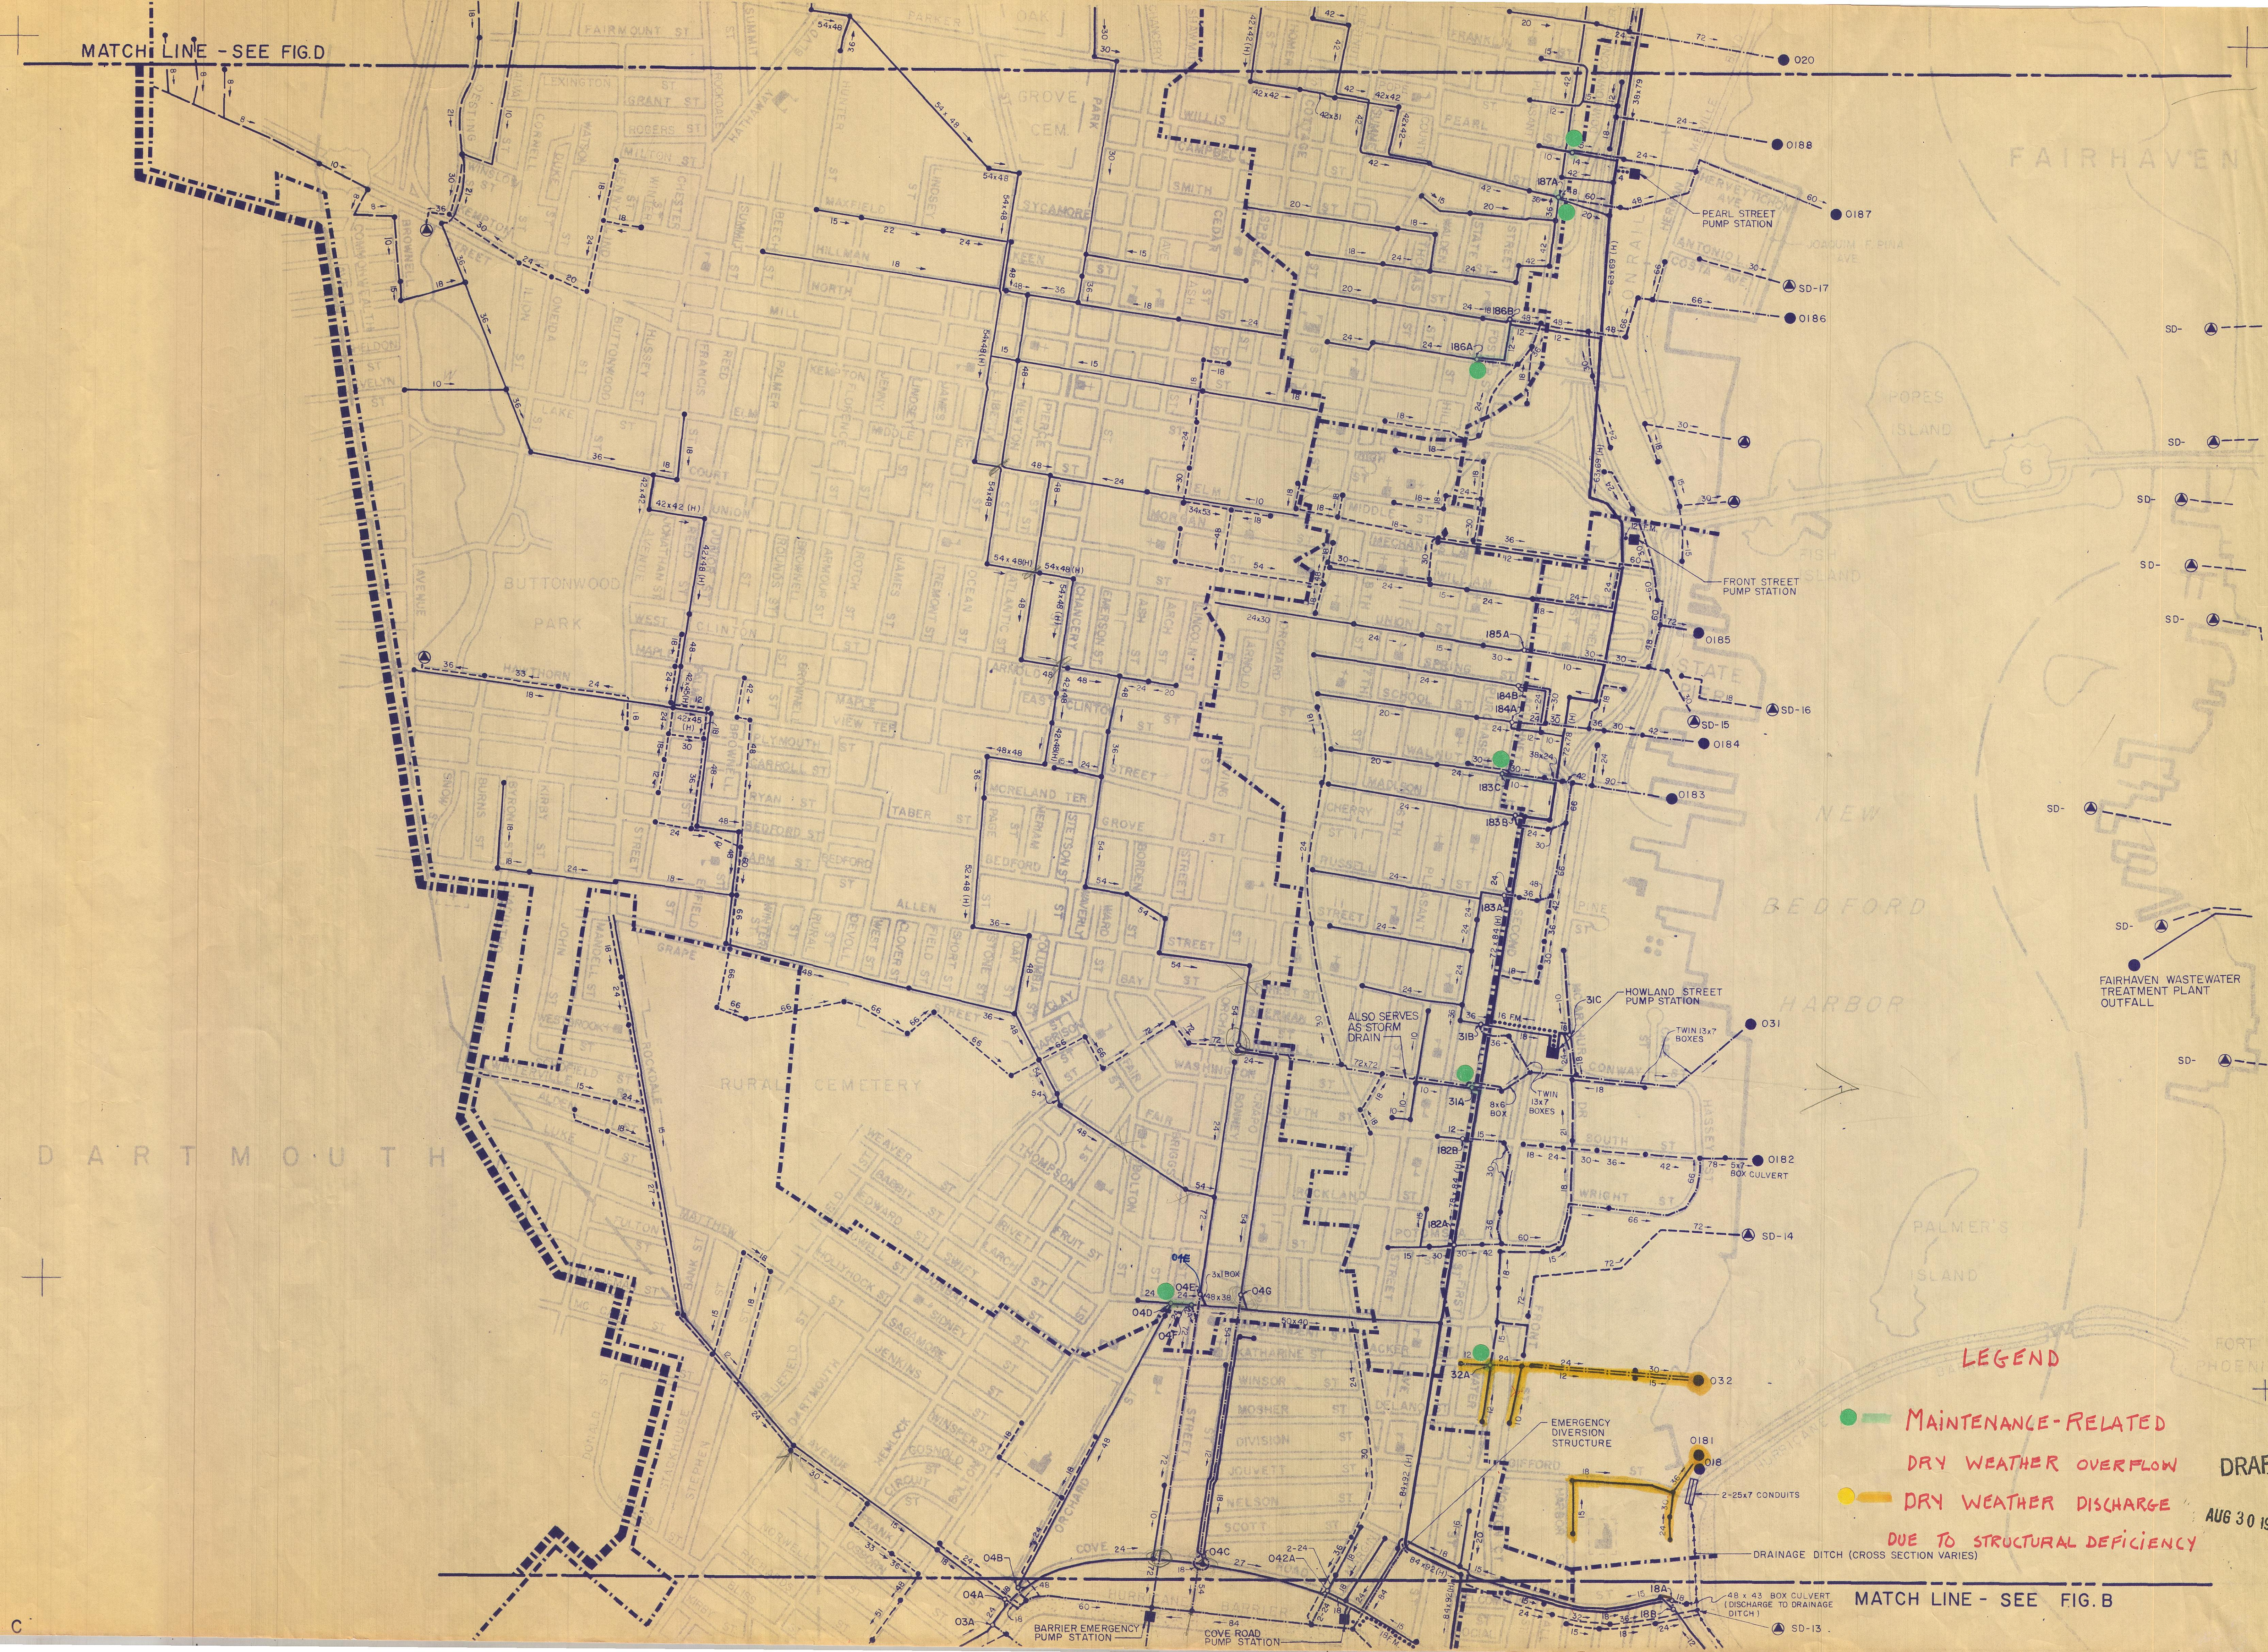

LEGEND

● MAINTENANCE-RELATED

DRY WEATHER OVERFLOW

● DRY WEATHER DISCHARGE

DUE TO STRUCTURAL DEFICIENCY

DRAINAGE DITCH (CROSS SECTION VARIES)

MATCH LINE - SEE FIG. B

DRAFT

AUG 30 1983