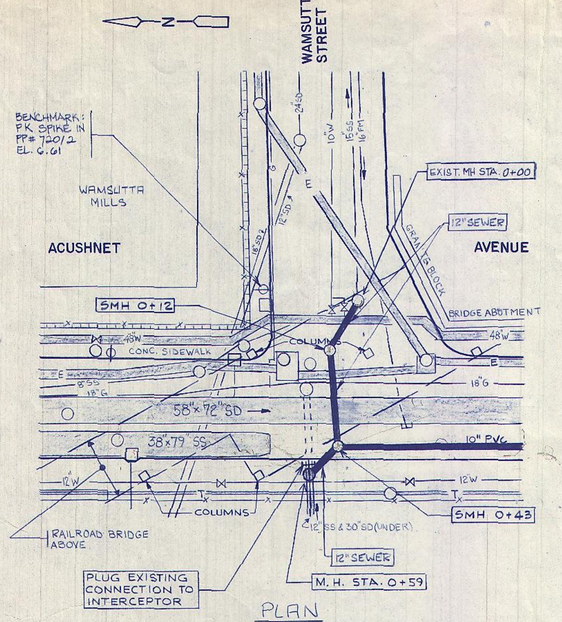

PLAN
1"=20'

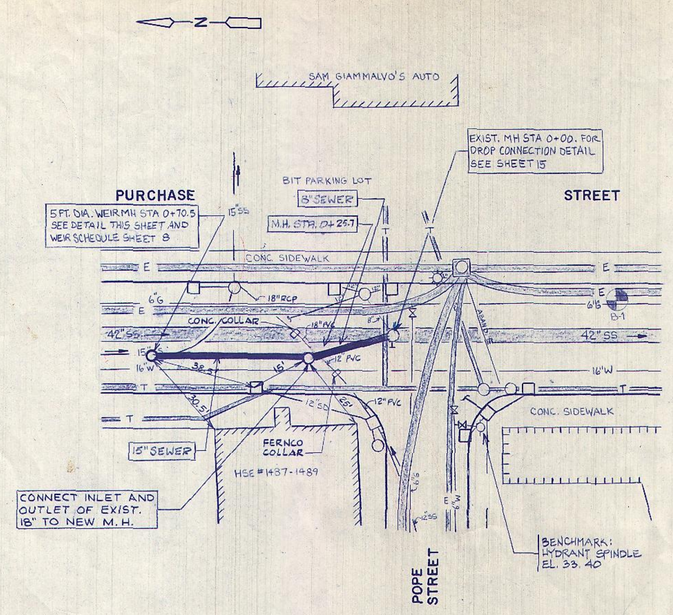

PLAN
1"=20'

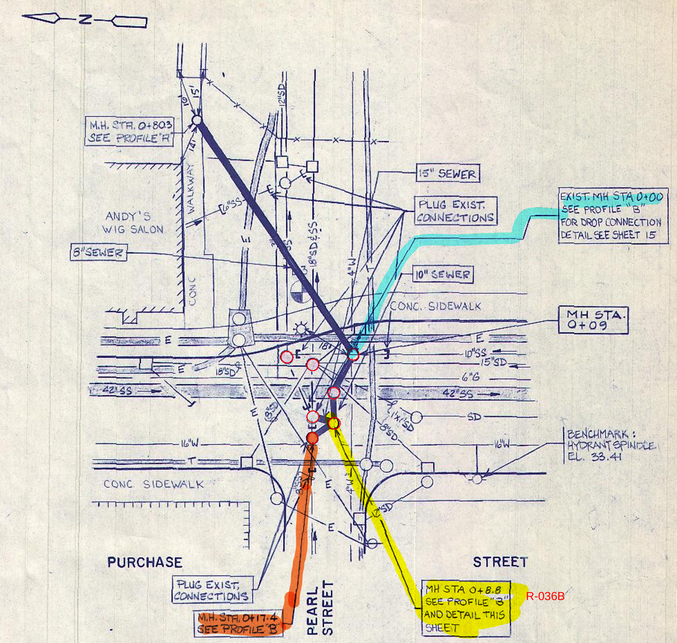

PLAN
1"=20'

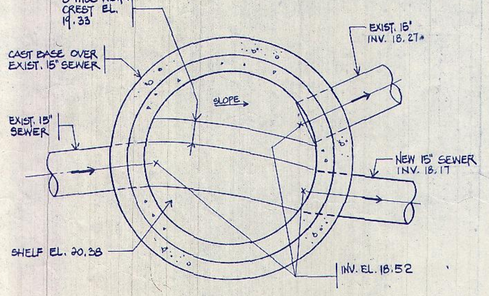

MANHOLE DETAIL
POPE STREET
SCALE: 1/2"=1'-0"

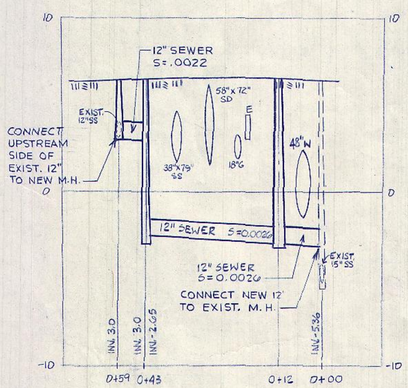

PROFILE - WAMSUTTA ST.
HOR. 1"=20'
VER. 1"=4'

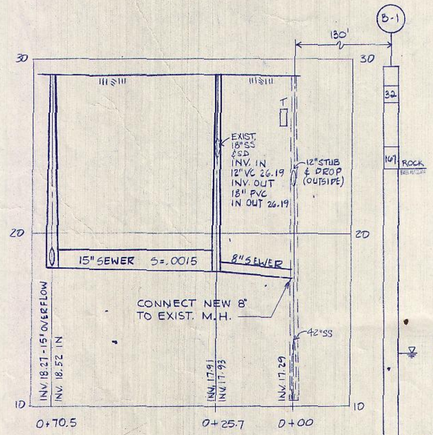

PROFILE - POPE ST.
HOR. 1"=20'
VER. 1"=4'

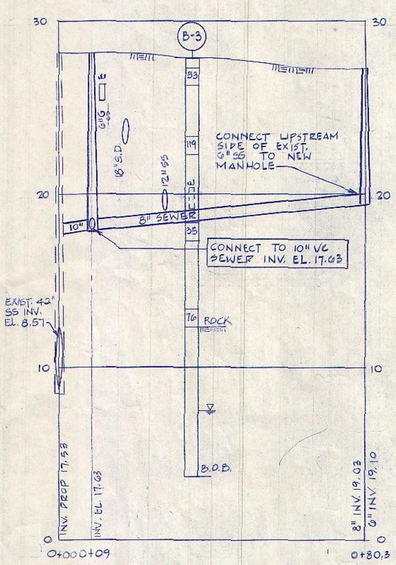

PROFILE "A"
HOR. 1"=20'
VER. 1"=4'

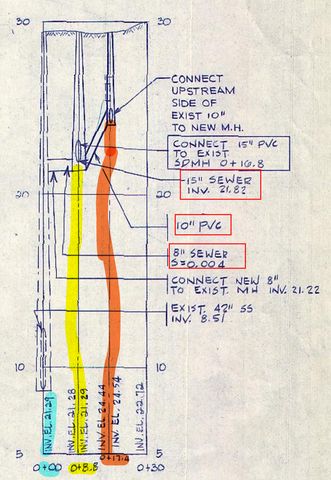

PROFILE "B"
HOR. 1"=20'
VER. 1"=4'

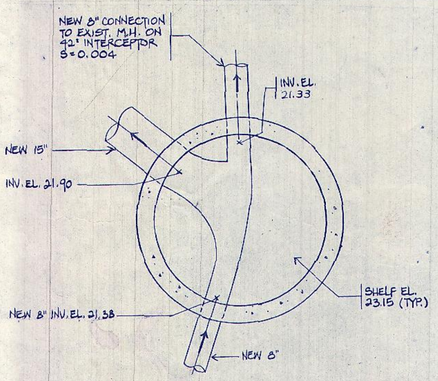

MANHOLE DETAIL
PEARL STREET
SCALE: 1/2"=1'-0"

RECORD DRAWING

Date	Ch'k'd.	Revision
2/95		REVISED FOR RECORD DRAWING

Designed by: SAB/AGZ
Drawn by: JJB
Checked by: SAB
Approved by: SJH
Date: MAY 1991
Scale: AS SHOWN

CITY OF NEW BEDFORD, MASSACHUSETTS
BELLEVILLE AVENUE FORCE MAIN EXTENSION
CONTRACT NO. 5

ENLARGED PLANS AND PROFILES

CAMP DRESSER & McKEE INC.
Ten Cambridge Center
Cambridge, Massachusetts 02142
CDM
environmental engineers, scientists, planners, & management consultants

SHEET NO. 14
309-47813

PROJECT MANAGER Date: Approved by:
PROJECT ENGINEER Date: 11/91 Approved by:
PLUMBING Date: Approved by:
HVAC Date: Approved by:
INSTRUMENTATION Date: Approved by:
ELECTRICAL Date: Approved by:
STRUCTURAL Date: Approved by:
ARCHITECTURAL Date: Approved by:

APPLIED IMAGE, INC.