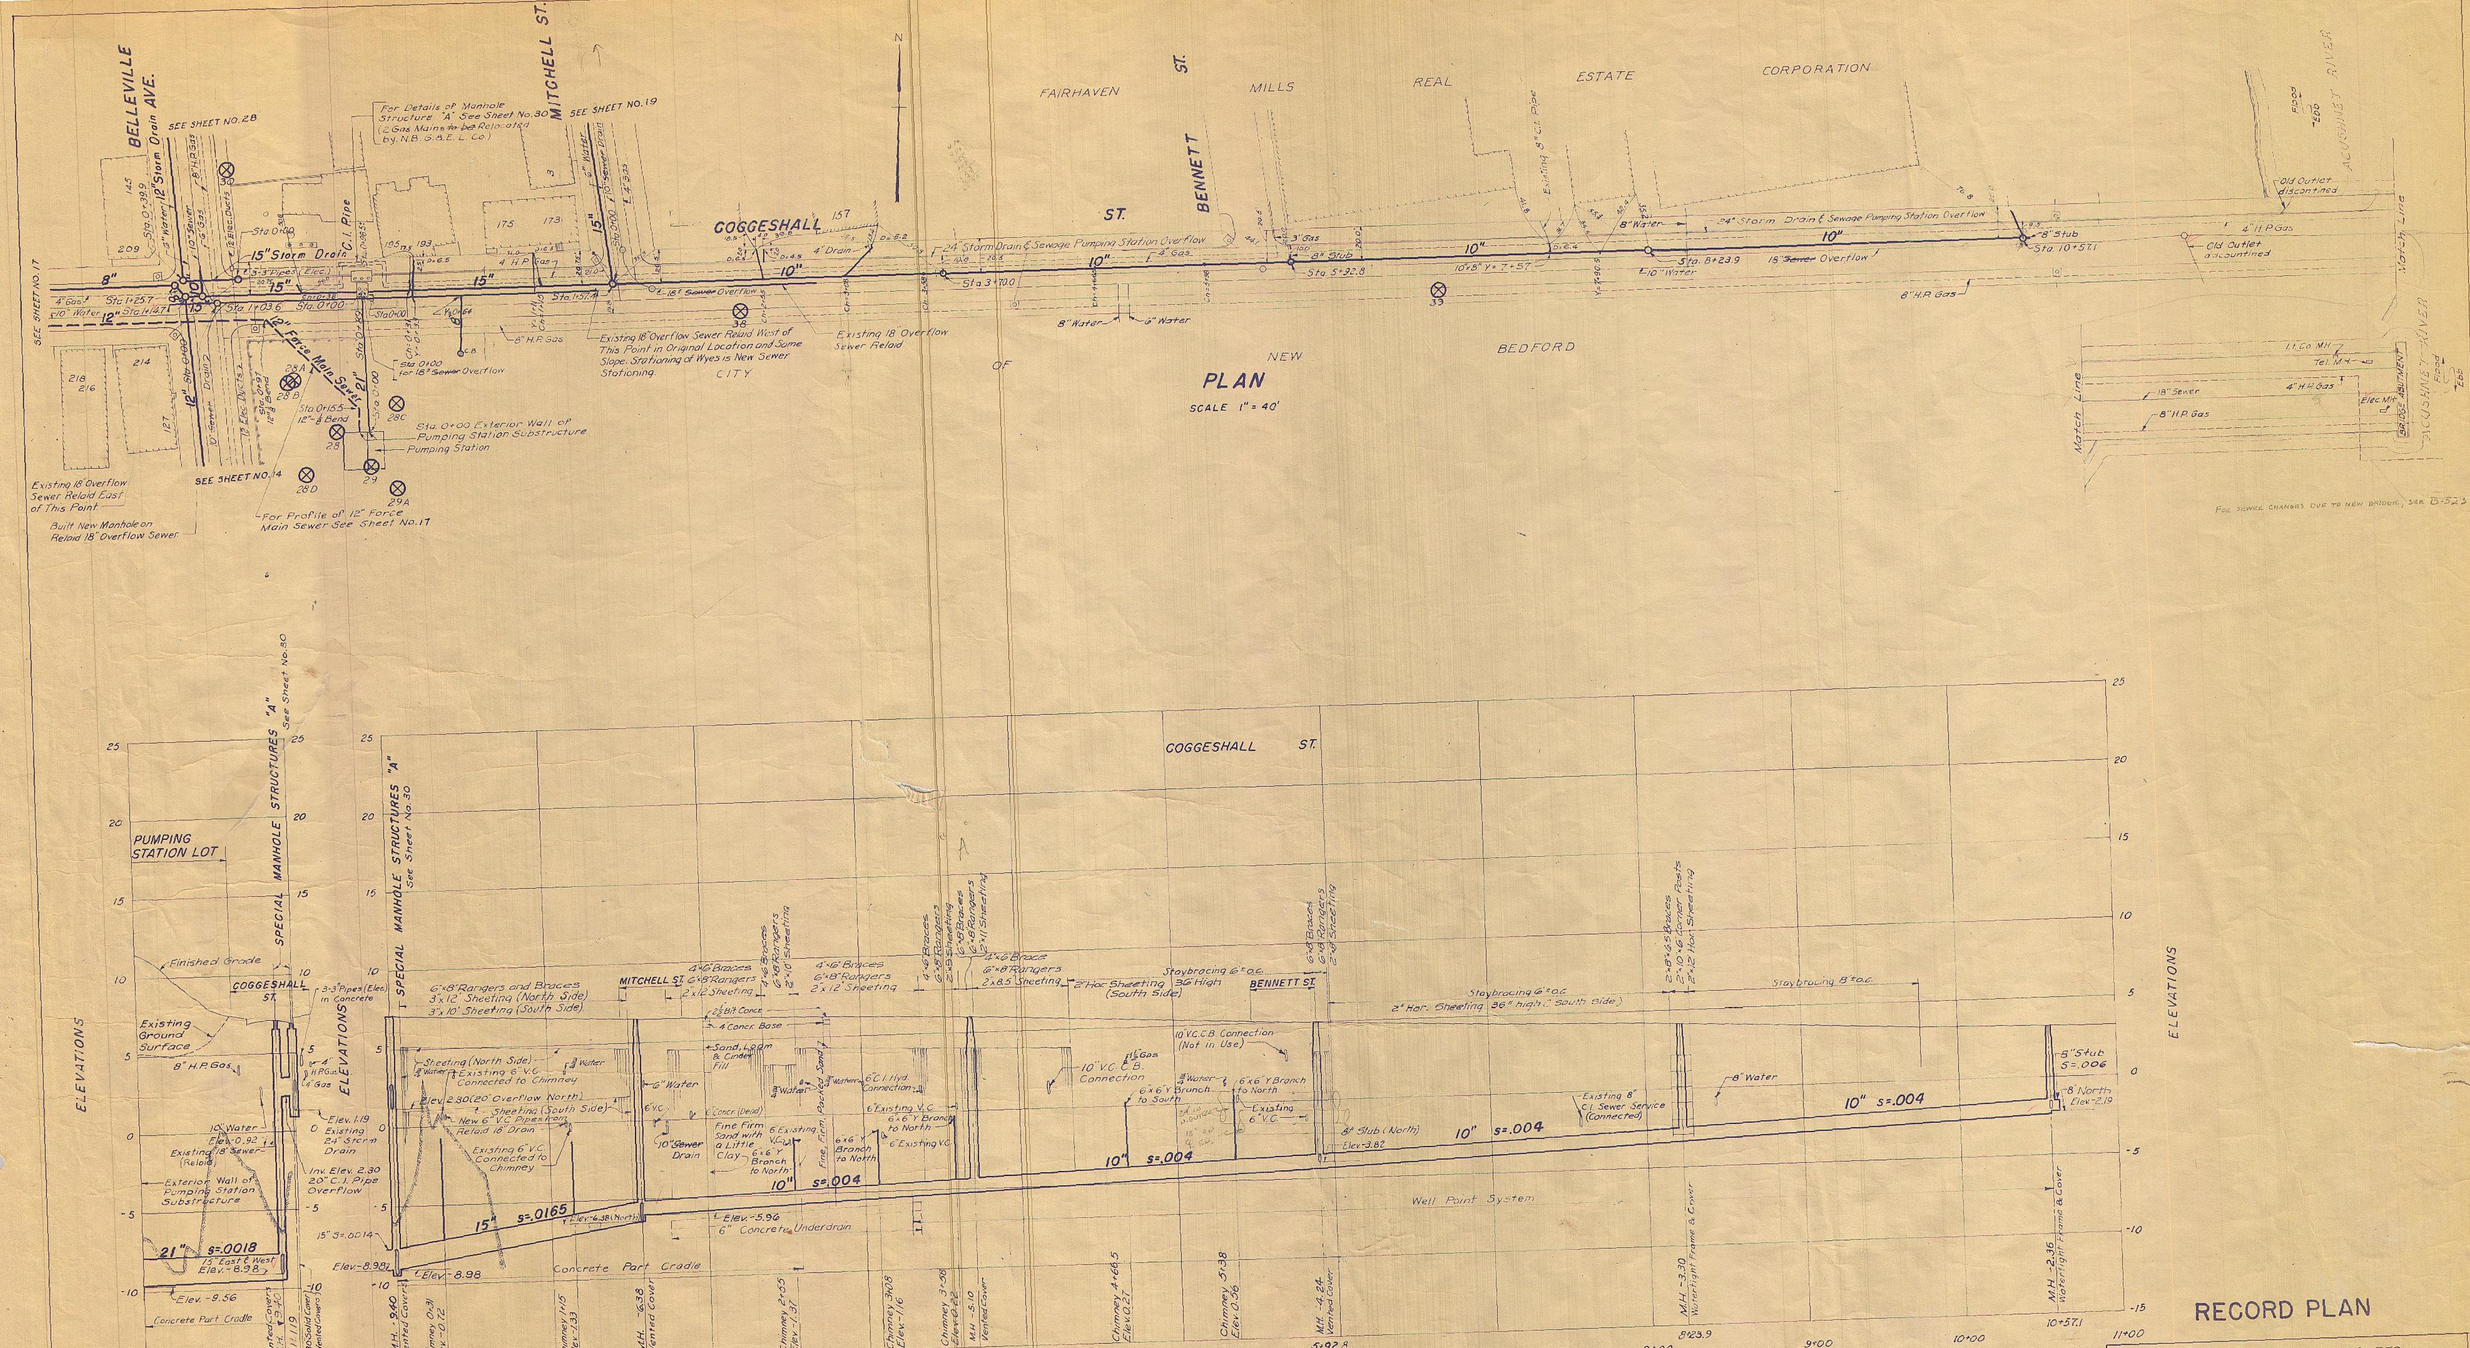

PROFILE
SCALES HOR. 1" = 40'
VERT. 1" = 4'

PROFILE
SCALES HOR. 1" = 40'
VERT. 1" = 4'

FOR DETAILS, GENERAL NOTES AND LEGEND SEE SHEET NO. 29 AND SHEET NO. 33

REV. NO.	DATE	DESCRIPTION	MADE BY	CH'K. BY	APP'D. BY
1	2-15-51	Revised as built.	DPT	GCC	H

REVISIONS

RECORD PLAN

NEW BEDFORD, MASSACHUSETTS
DEPARTMENT OF PUBLIC WORKS

ADDITIONS TO INTERCEPTING SEWER SYSTEM

SEWERS

PUMPING STA. LOT (PUMPING STA. to COGGESHALL ST.)
COGGESHALL ST. (PUMPING STA. to East of BENNETT ST.)

SCALE AS NOTED — OCT. 1948

FAY, SPOFFORD & THORNDIKE, ENGINEERS, BOSTON, MASS.

DES. 10.R.G. DR. G.R. — TR. F.J.V. CHK. G.C.C., C.S.M., C.P.S. — FILE NO. Jn-1

APPROVED R. W. Horne — PLAN NO. 25

CONTRACT DRAWING — SHEET NO. 18 OF 33