2276

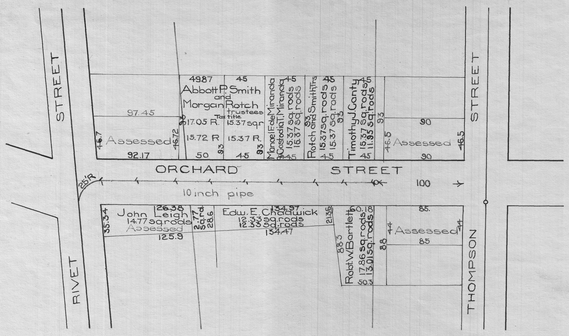

ORCHARD STREET SEWER

FROM RIVET ST. TO 100 FT. S. OF THOMPSON ST.

LENGTH

417.6 ft. of glazed pipe 10 inches in diameter

SCALE

Horizontal, 1 inch = 60 feet Vertical 1 inch = 6 feet

BENCH MARK

Stone bound N.W. cor. Bonney and Rivet elev. 10.60

Ordered	June 12, 1899
Construction Commenced	June 30, 1899
Average Depth	7.70 feet
Ledge Excavated	None
Cost	$ 340.66
Amount Assessed	$ 170.33
Foreman	Alexander Cook

Field book 107 page 37

William T. Williams
CITY ENGINEER.

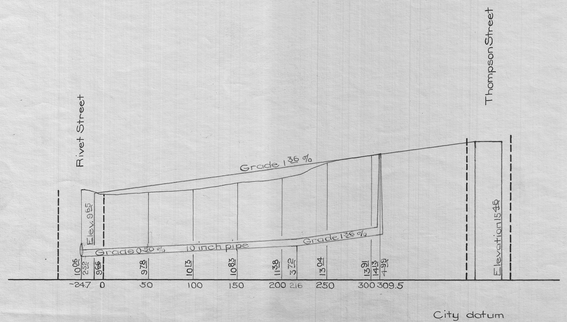

2276

2276