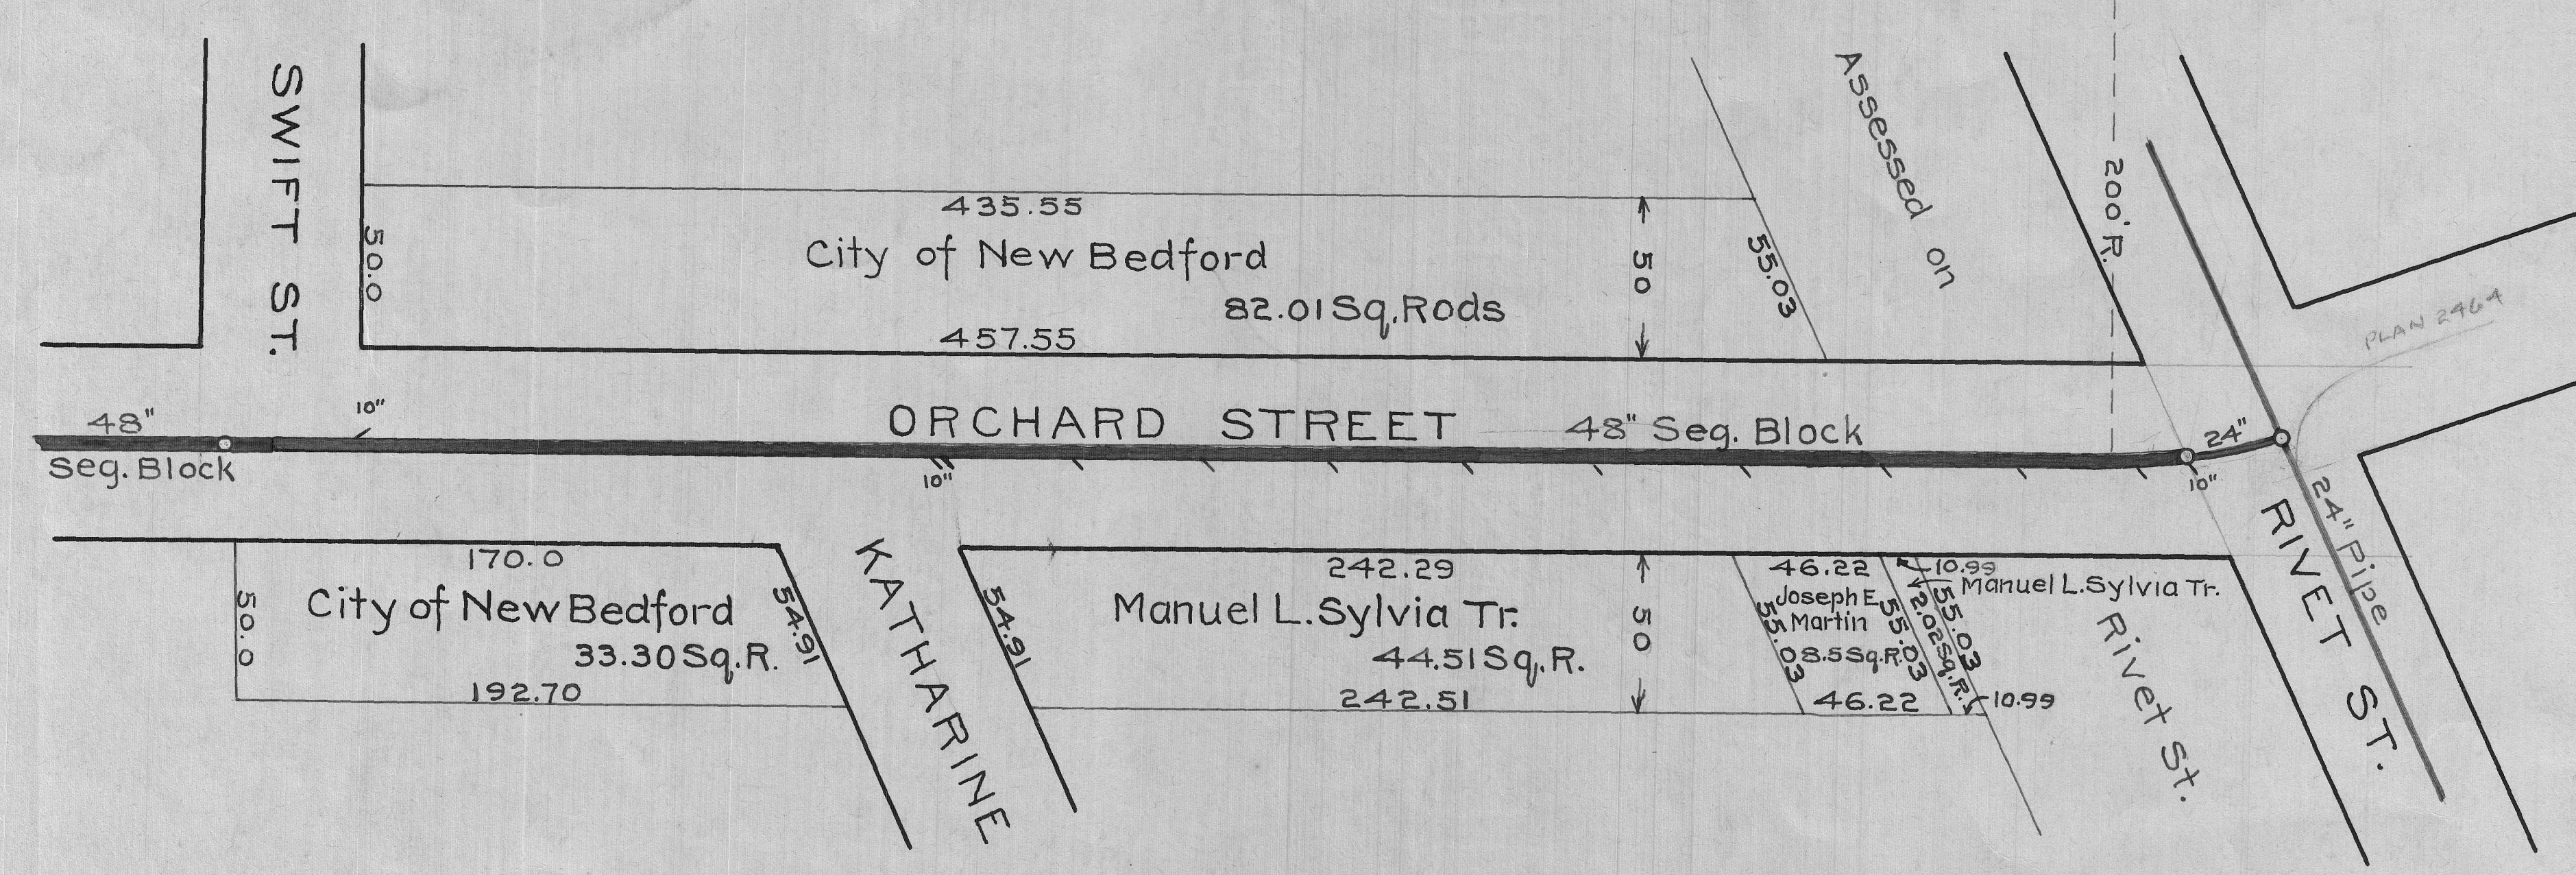

SECTION OF SEWER
Same as shown on Sewer Plan 2638

ORCHARD STREET SEWER

FROM SWIFT ST. TO RIVET ST.

LENGTH

598.0 feet of segmental block 48 inches in diameter
29.43 feet of vitrified pipe 24 inches in diameter

SCALE

Horizontal, 1 inch = 60 feet. Vertical, 1 inch = 6 feet.

Ordered	July 30, 1915
Construction Commenced	Sept. 24, 1915
Construction Completed	Nov. 20, 1915
Average Cut	8.66 feet
Ledge Excavated	None
Cost	$ 5903.14
Amount Assessed	$ 1200.0

Foreman J. Frazier

Field Book 409 p. 18, 22.

CITY ENGINEER

M.H. ORCHARD AND RIVET STREET

Scale, $\frac{1}{2}$" = 1'

ELEVATION

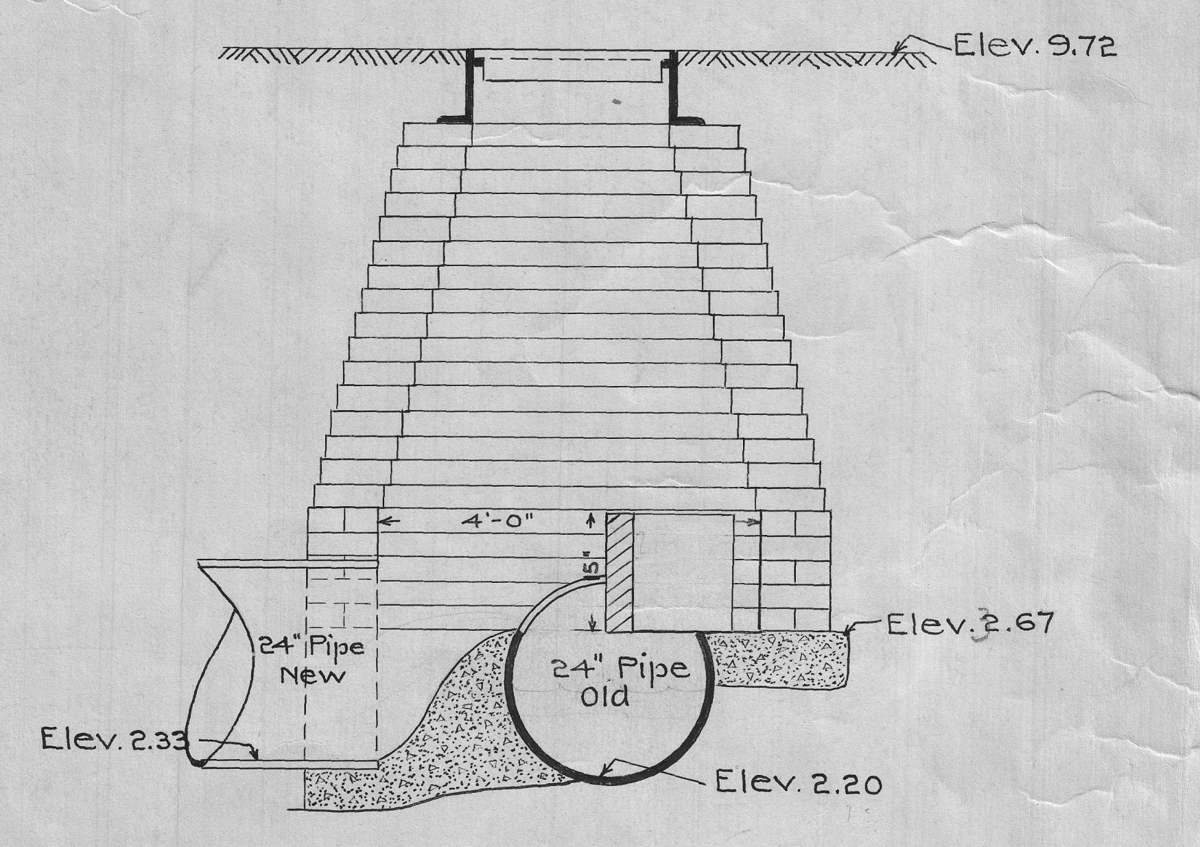

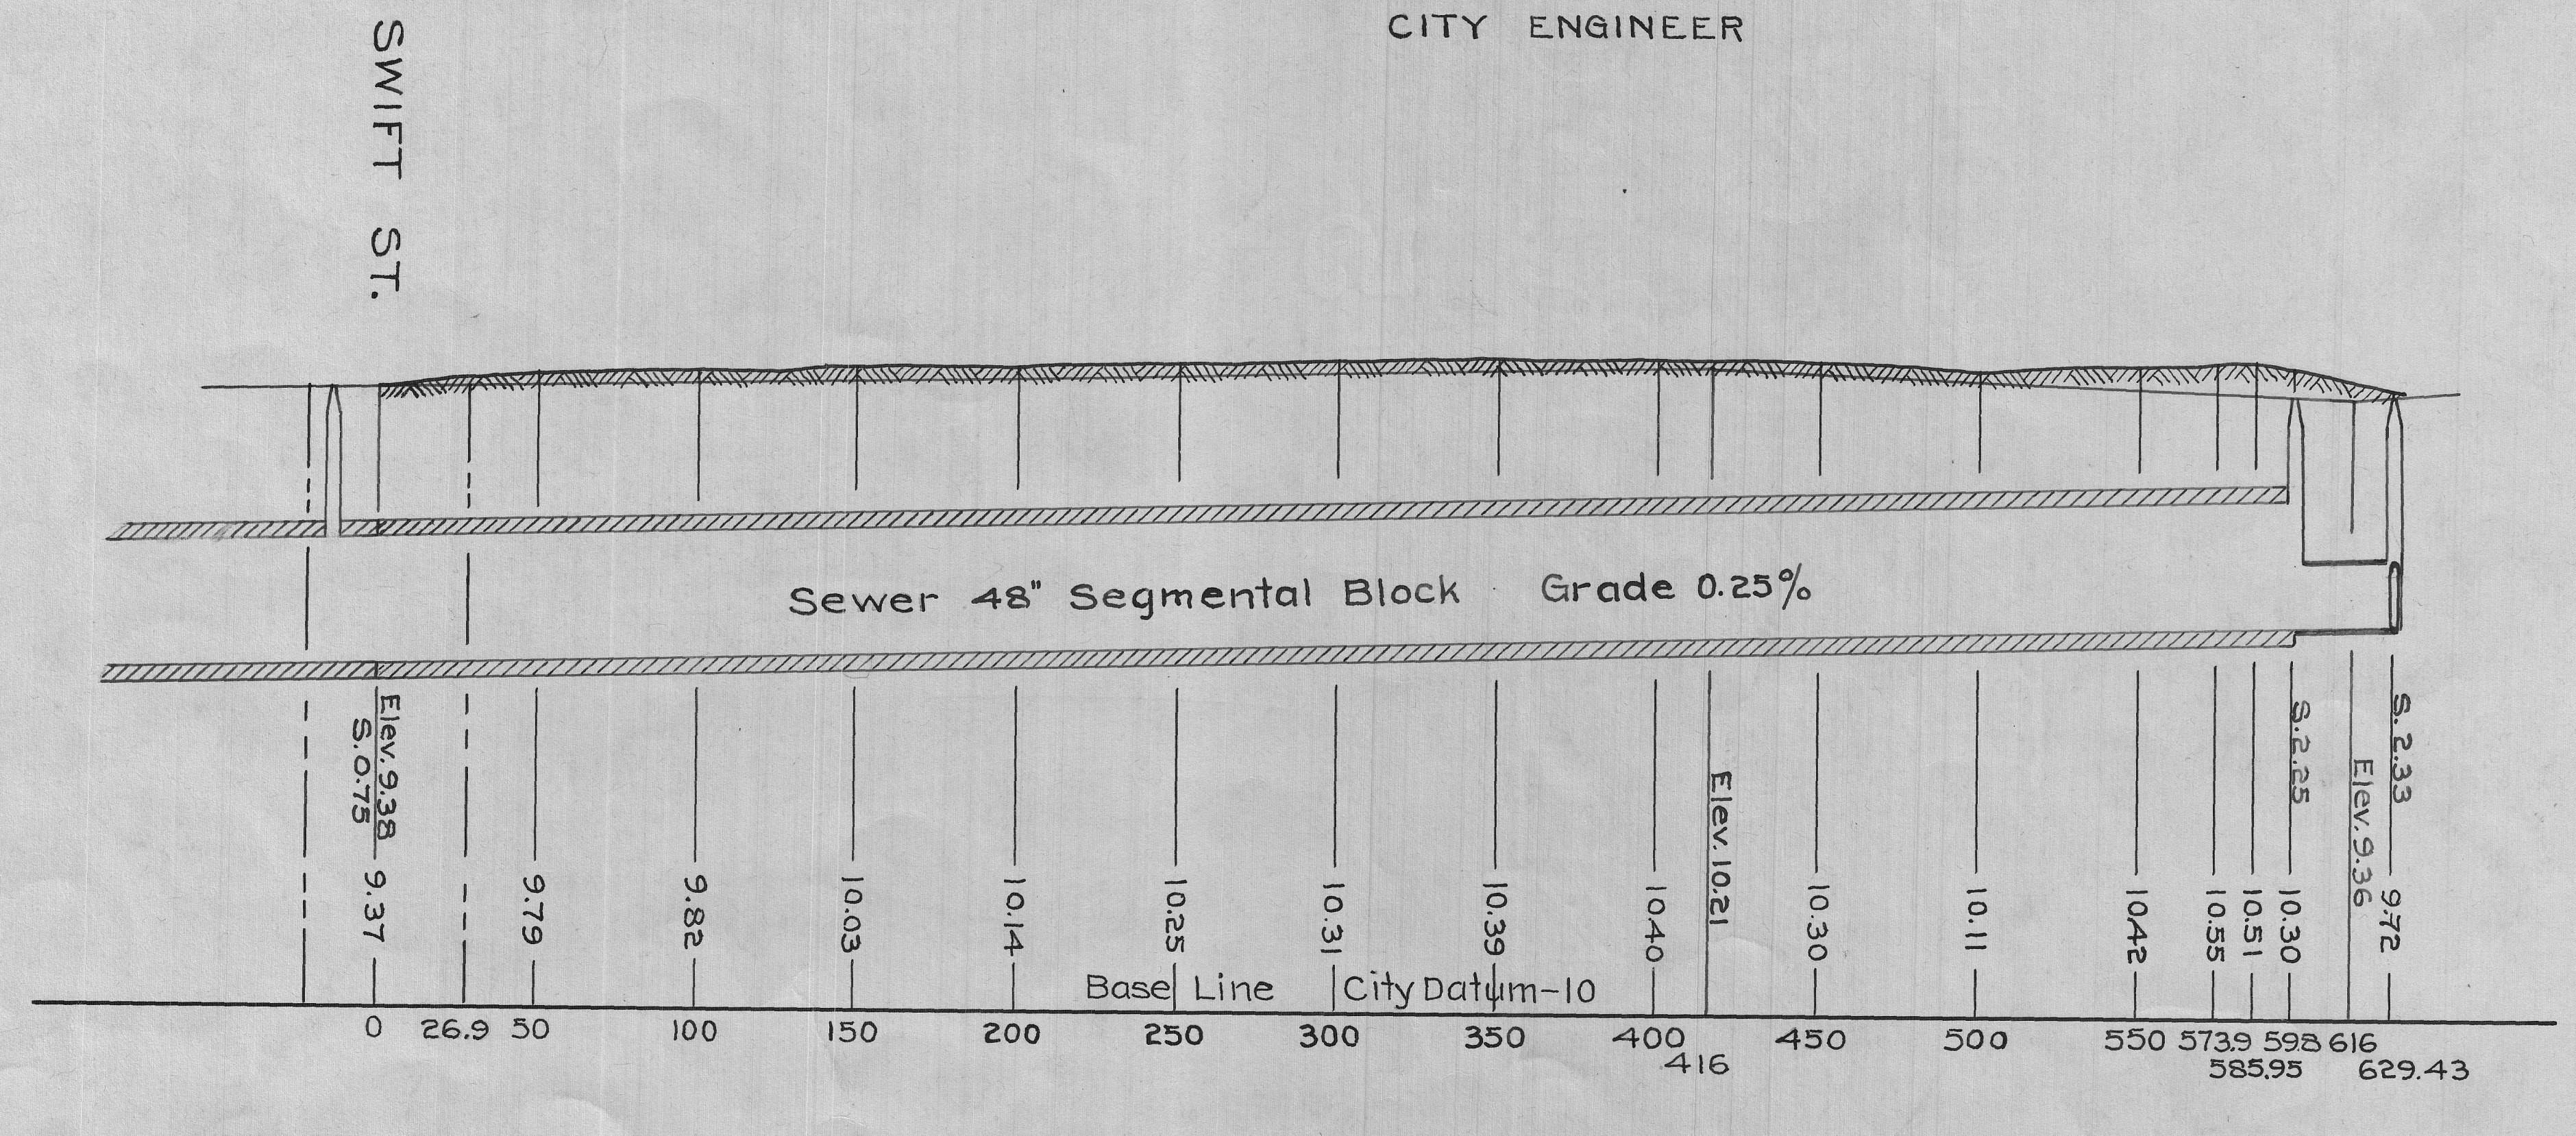

PLAN