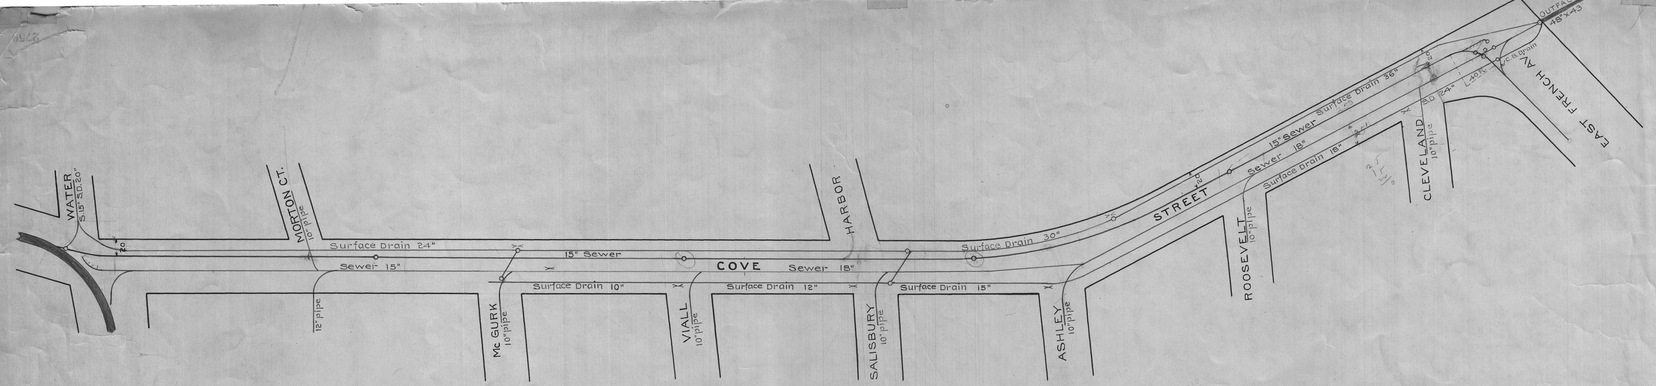


SHEET NO. 1

COVE STREET SEWER

EAST FRENCH AVE. to WATER STREET

LENGTH

1650 feet of glazed pipe 15 inches in diameter

SCALE

Horizontal, - 1 inch = 60 feet. Vertical, - 1 inch = 6 feet

Ordered	May 23, 1917
Construction Commenced	May 28, 1917
Construction Completed	Oct. 31, 1917
Average Cut	12.65 feet
Ledge Excavated	409 Cu. Yards
Cost	$ 23,518.80
Amount Assessed	None
Foreman	D. Mc Crohan
	Field Book 332 p 40, 52

CITY ENGINEER

