



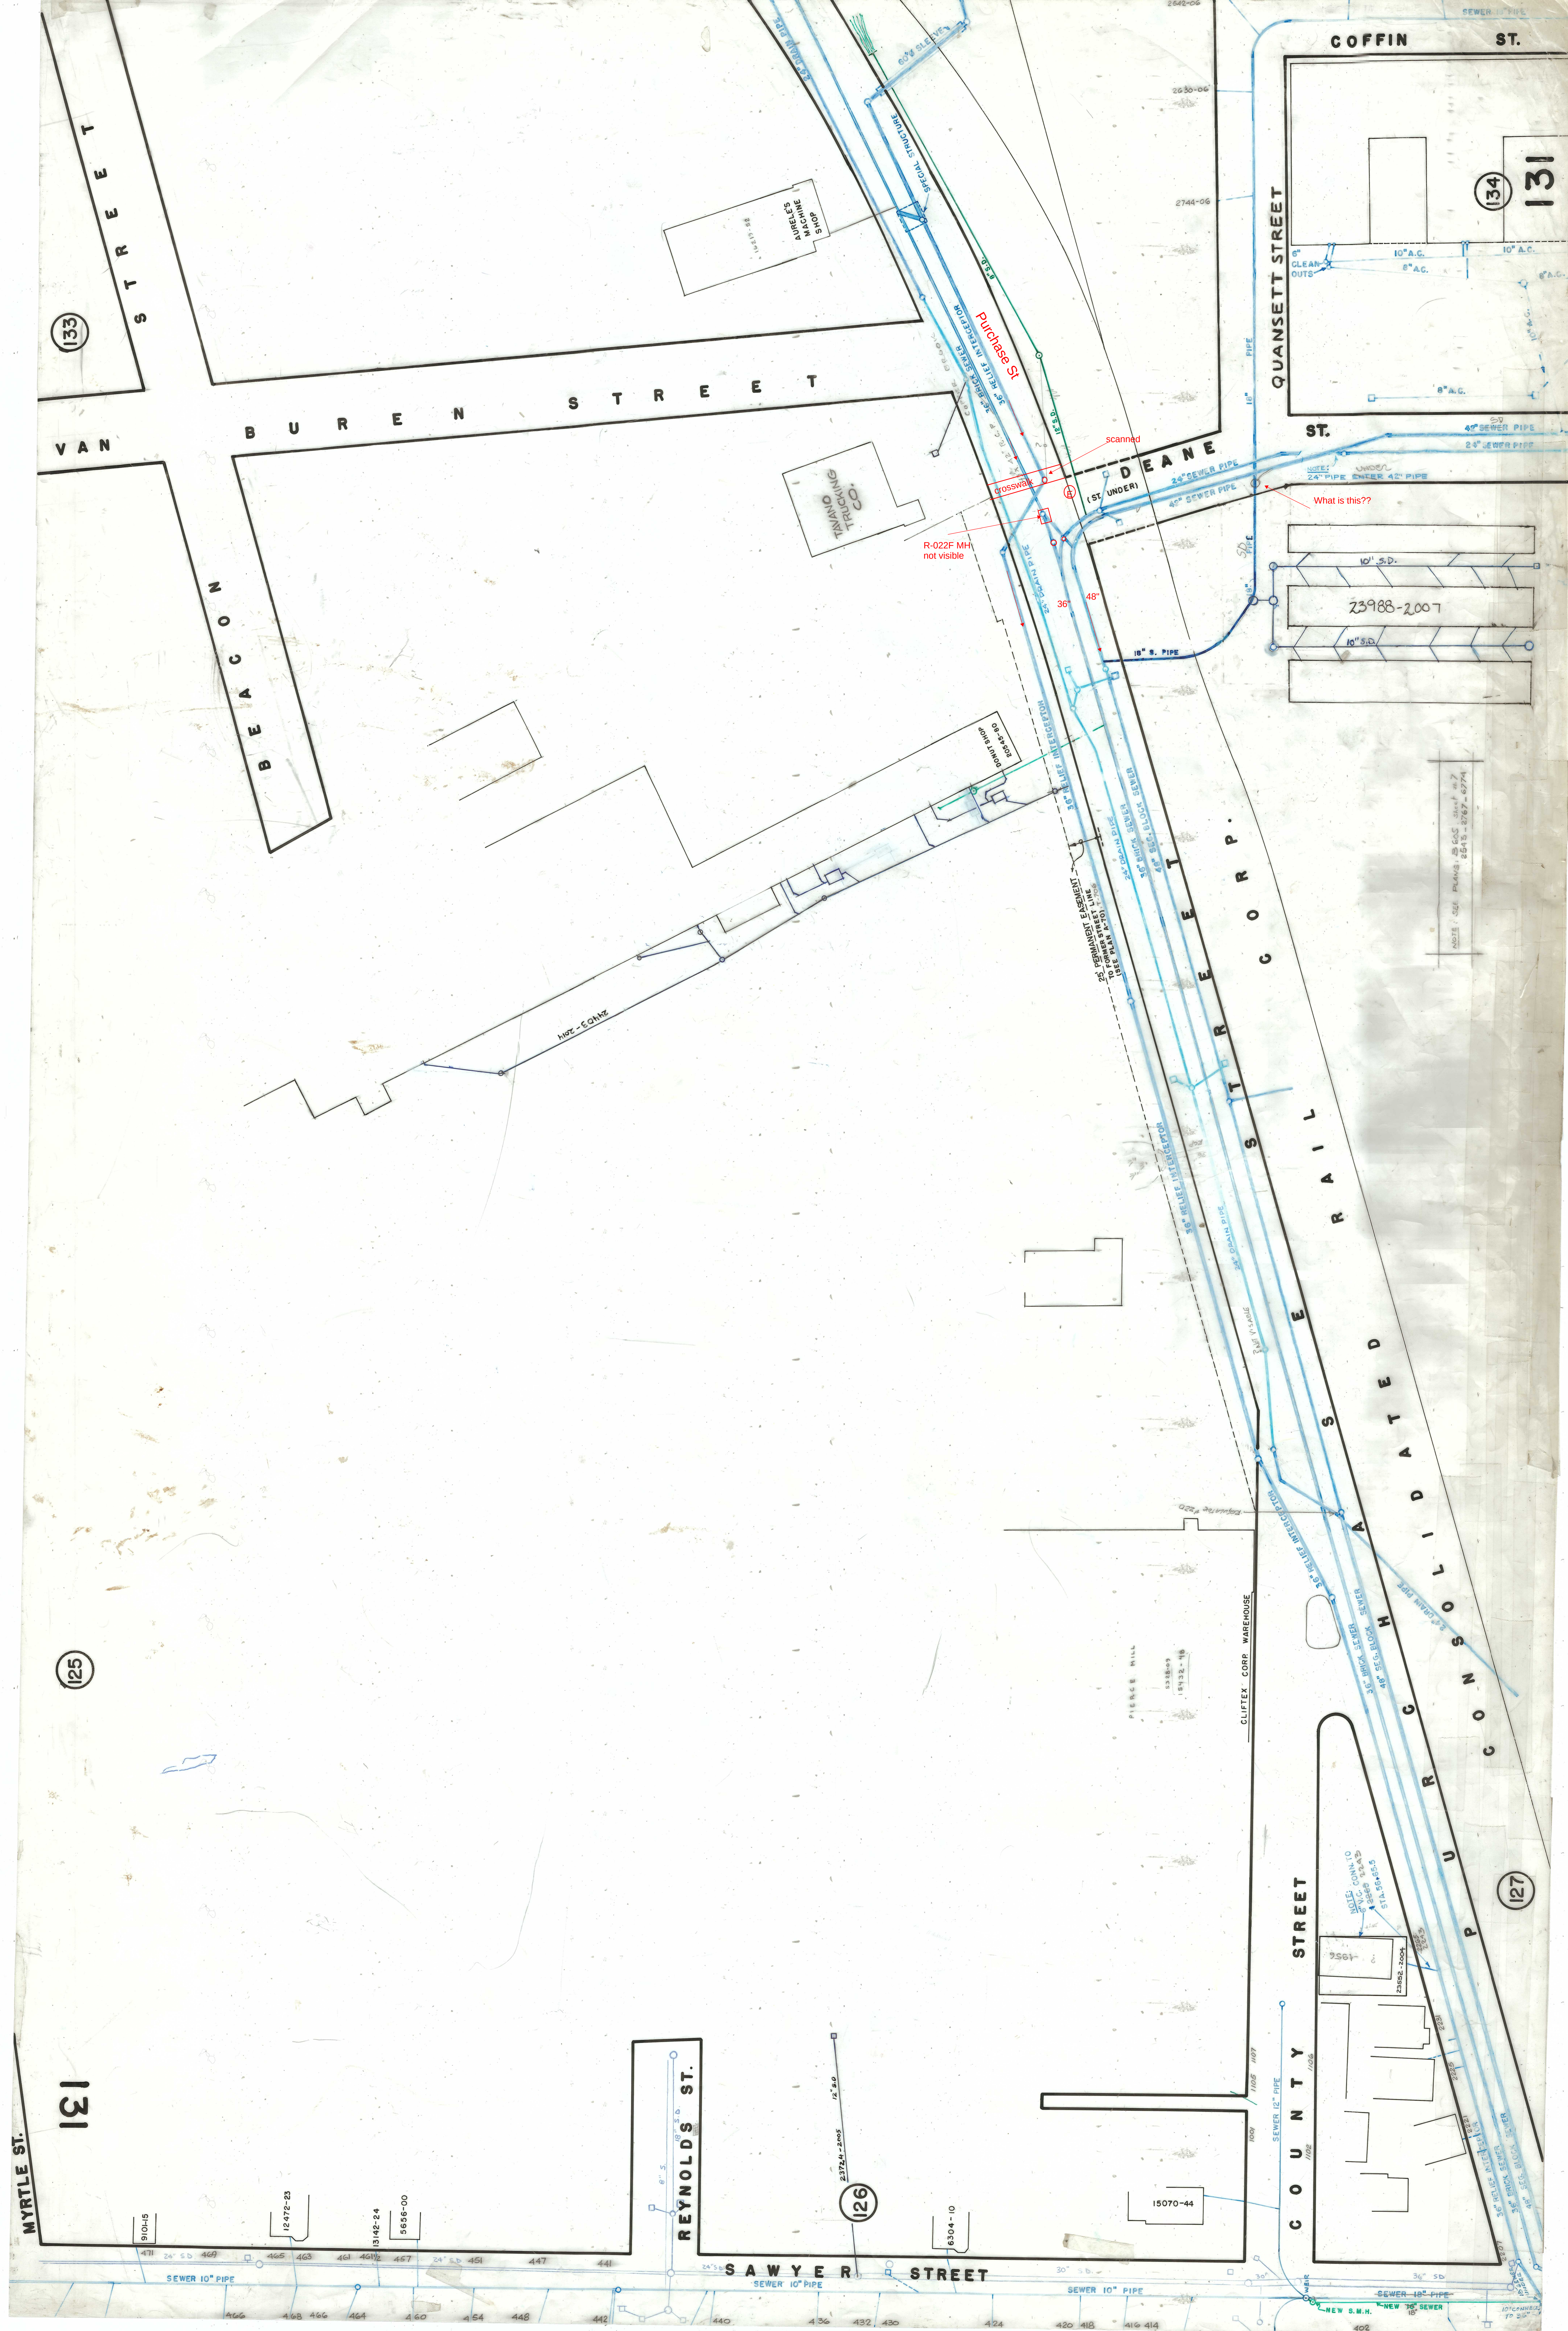

P2767


Brick

PLAN AND ELEVATIONS OF
WEIR AND FLUME
PURCHASE AND DEANE

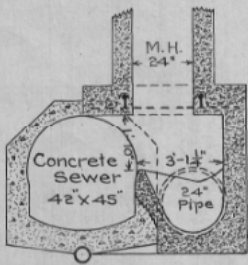


END ELEVATION ON B-B

Scale, - $\frac{1}{4}$ " = 1'

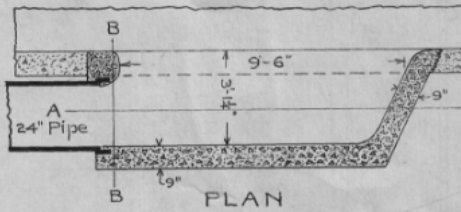

PLAN

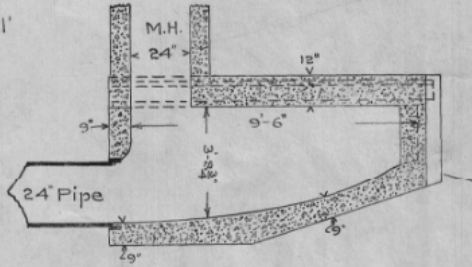

SIDE ELEVATION ON A-A

