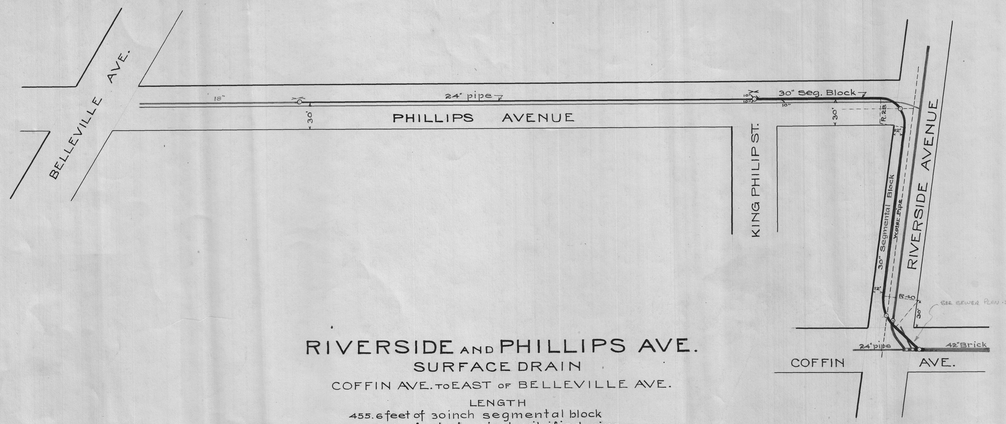

RIVERSIDE AND PHILLIPS AVE.

SURFACE DRAIN

COFFIN AVE. TO EAST OR BELLEVILLE AVE.

LENGTH

455.6 feet of 30 inch segmental block
530.4 feet of 24 inch vitrified pipe

SCALE

Horizontal; 1 inch = 60 feet. Vertical; 1 inch = 6 feet

Ordered	June 14, 1920
Construction Commenced	Dec. 17, 1920
Construction Completed	Jan. 6, 1921
Average Cut	5.09 feet
Ledge Excavated	None
Cost	
Amount Assessed	

Foreman – P. Foley

Field Book – 505 p. 57

George H. Ryder
CITY ENGINEER