


Filename: S:\0309\40526\RECORD\CIVL\CSPL18A.dwg
Xref's: [C24X36H, CSPP0001]
Plotted by: CROSSIA Time: 10/05/2007 11:23:01 AM

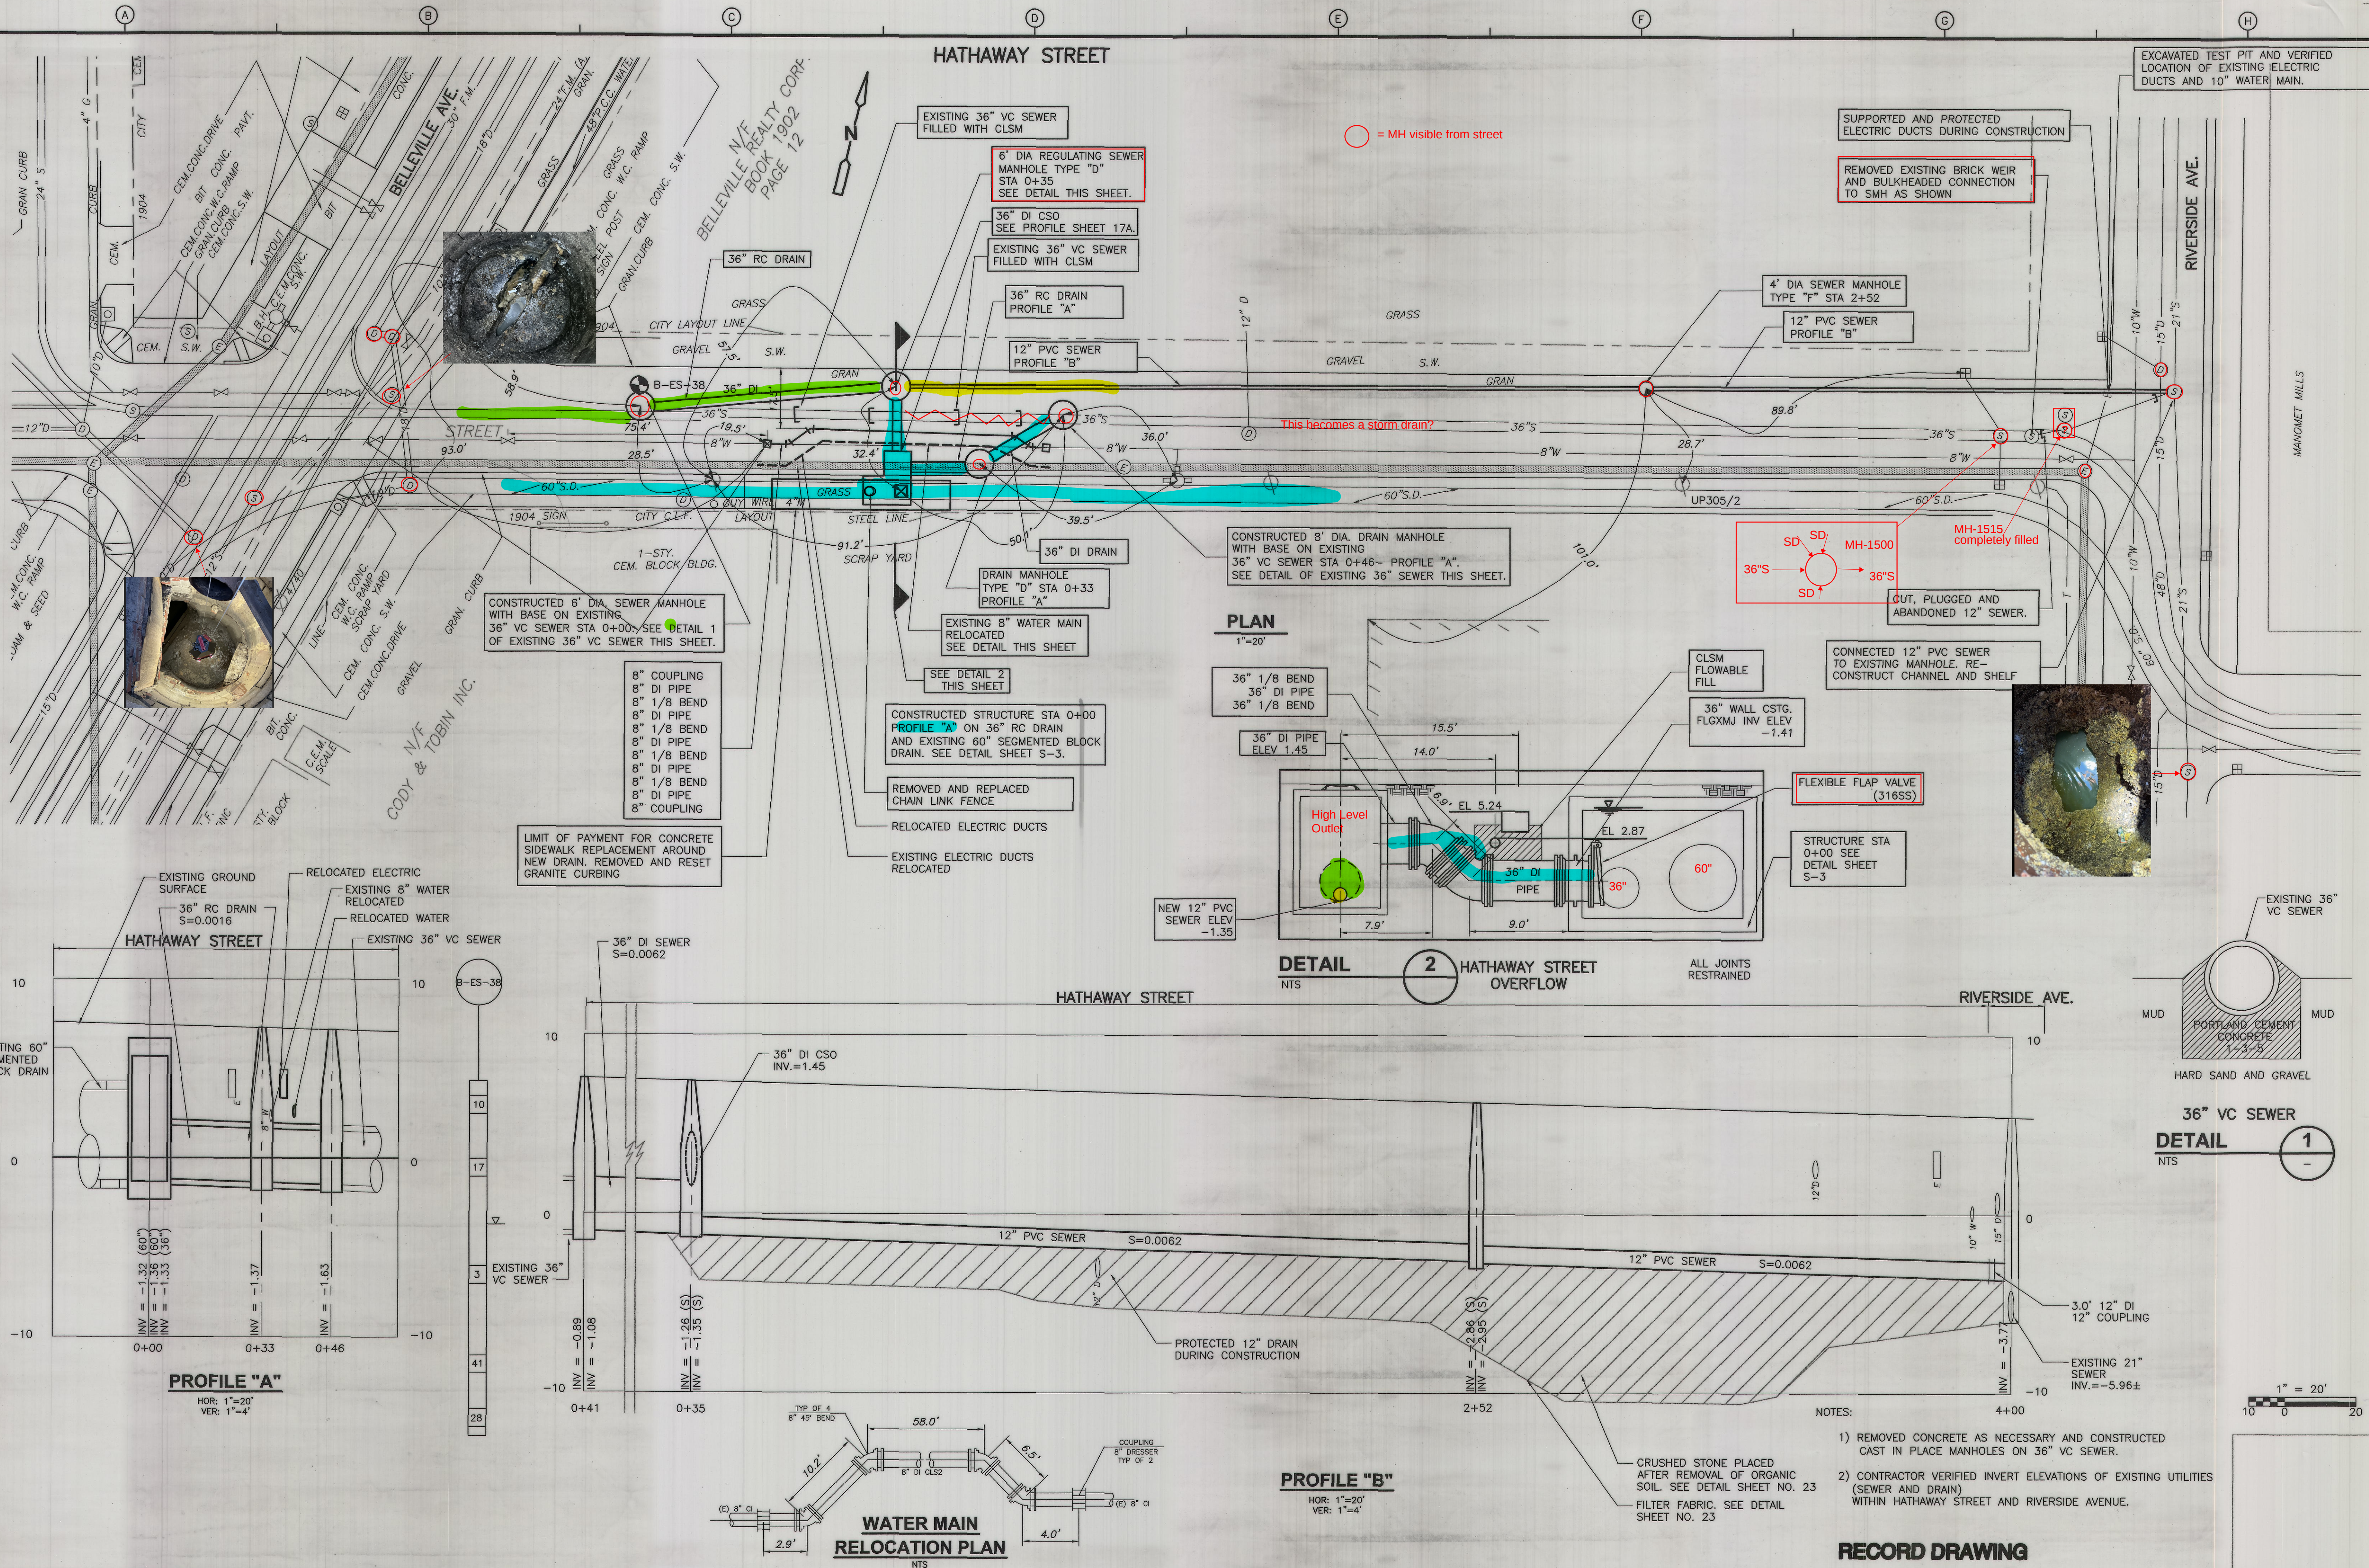

					DESIGNED BY: <u>S. SYDE</u>	 Camp Dresser & McKee Inc. consulting engineering construction operations	CITY OF NEW BEDFORD, MASSACHUSETTS WASTEWATER SYSTEM IMPROVEMENTS EARLE STREET SEWER SEPARATION	PROJECT NO. 0309-40526 FILE NAME: CSTPL0018a HATHAWAY STREET SHEET NO. 17 Accession No: 0309-P-1316
					DRAWN BY: <u>S. SYDE</u>			
					SHEET CHK'D BY: <u>A. CABRAL</u>			
					CROSS CHK'D BY: <u>J. KEANEY</u>			
					APPROVED BY: <u>S. HICKOX</u>			
REV. NO.	DATE	DRWN	CHKD	REMARKS	DATE: <u>JUNE 2004</u>			
	3/07	SPV	ELS	REVISED FOR THE RECORD				