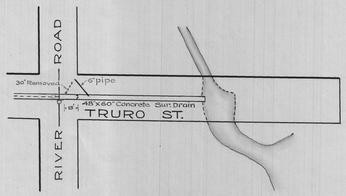

TRURO ST. SUR. DRAIN

FROM RIVER RD. EAST 143 FT.

SCALE

Horizontal; 1 in = 60 ft. Vertical; 1 in = 6 ft.

Ordered	Oct. 14, 1927
Construction Commenced	Oct. 21, 1927
Construction Completed	Dec 3, 1927
Average Cut	4.09 feet
Cost	$ 3252.57

CARD

George H. Nye

CITY ENGINEER

SECTION OF
CONCRETE SUR. DR.

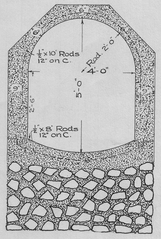

SCALE 1"-2'