R-030A

visited 3/21/25 at 3:15 pm

- Block missing
- meter present
- no flow gate
- 2 videos
- located the clean out chamber
- Rim to ledge: 6.05 ft
- Rim to bottom: 6.6 ft

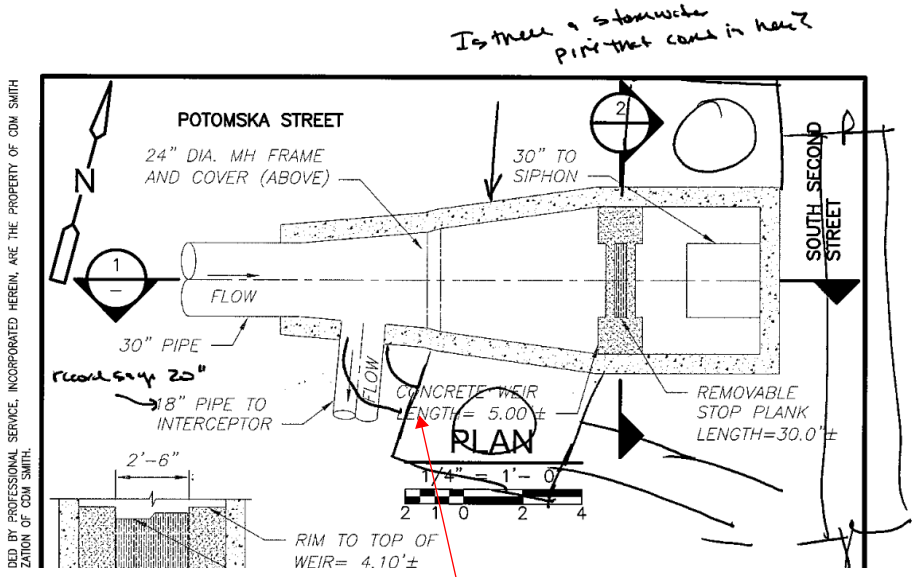

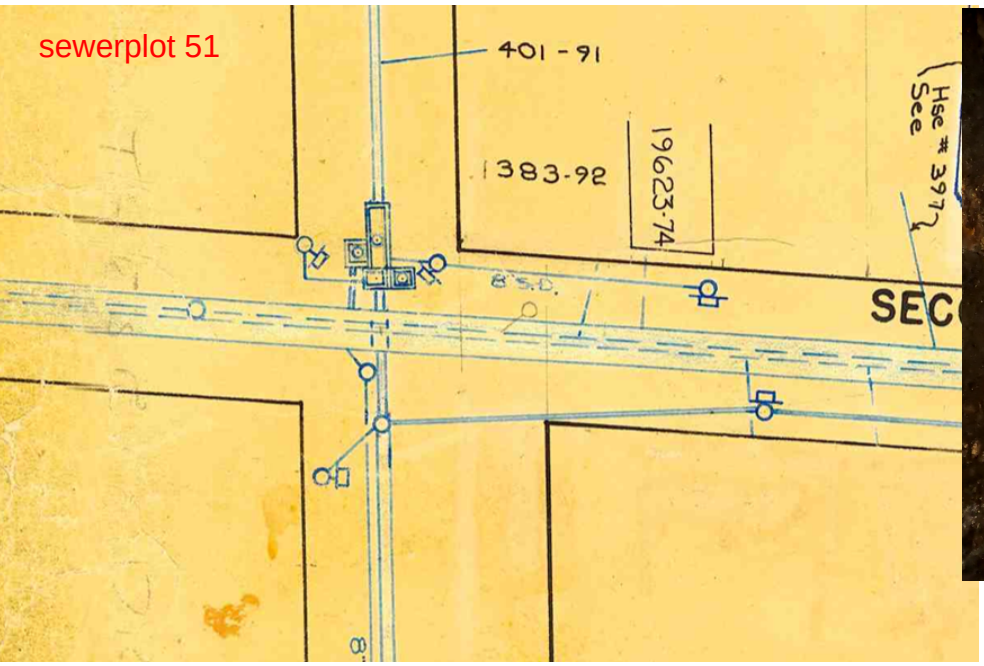

strange protrusion in 30" pipe entering R-030A

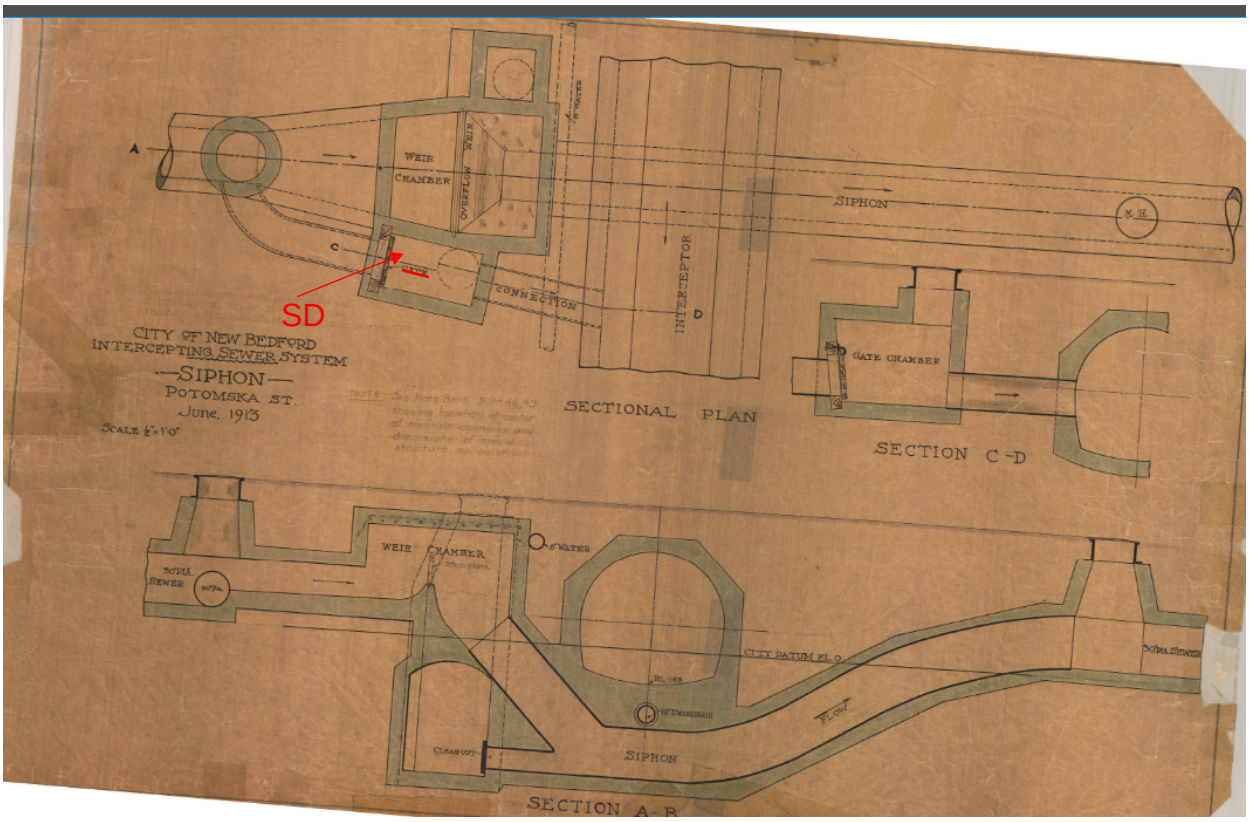

cleanout chamber mostly submerged

rim to bottom: 13.9 ft
approx 6ft of standing water