R-030B

visited 3/21/25 at 3:31pm

Notes:

Location:

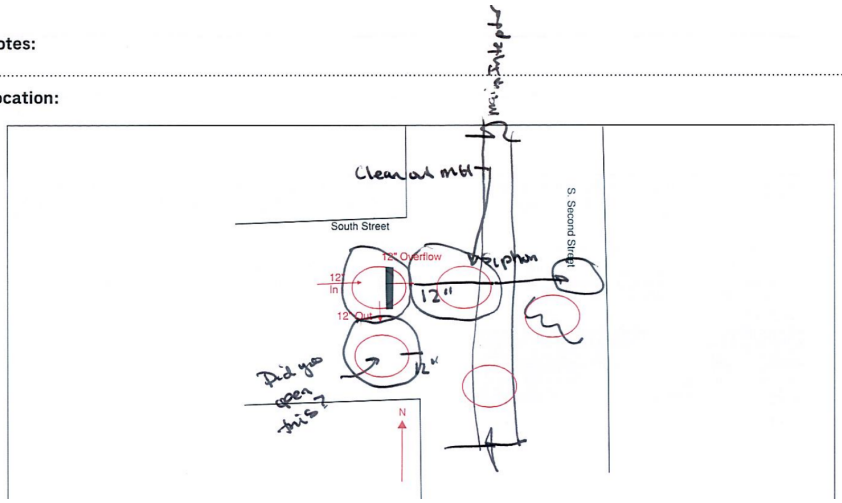

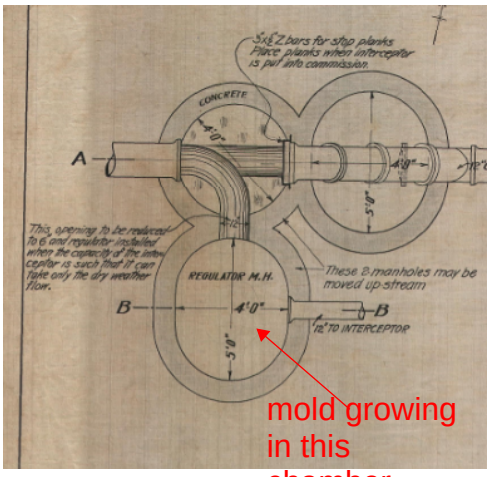

mold growing in this chamber.

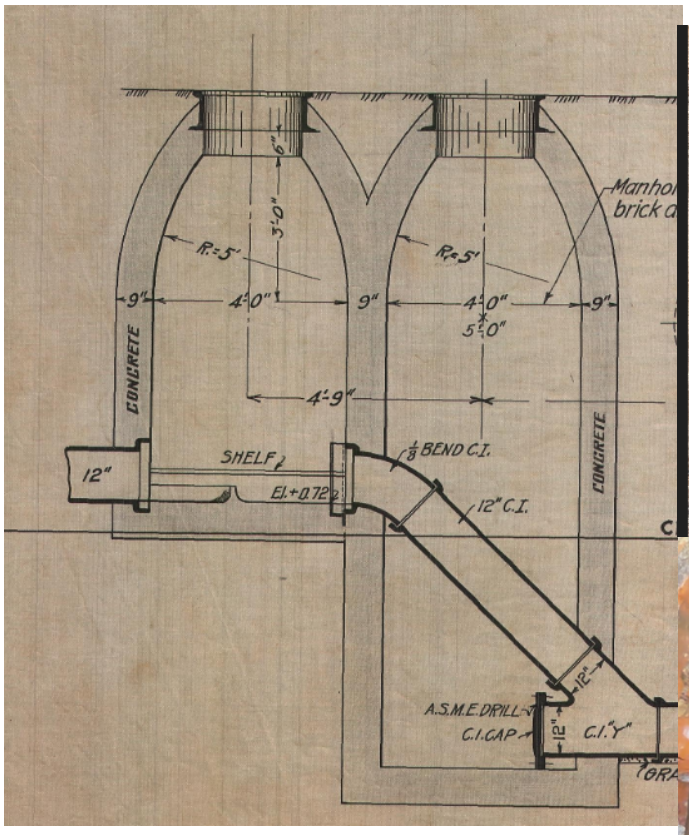

SD invert to Rim: 4.7ft

chamber bottom: 13.6 ft

rim to invert: 5.7ft

rim to invert: 8.6ft

chamber bottom: 8.6 ft