

HOWLAND ST. SEWER

FROM PROSPECT TO FIRST

SCALE


Horizontal-1in-60ft. Vertical-1in-6ft.

Ordered	May 13,1921
Construction Commenced	June 21,1921
Construction Completed	Aug. 8,1921
Average Cut	10.04 feet
Ledge Excavated	10.13 Cu. Yds.
Cost	$ 92.87.13

Foreman Wm. Smith

CARD

George H. Norris
CITY ENGINEER

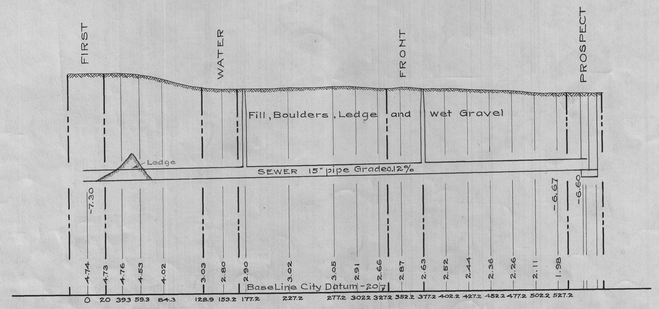

2959