



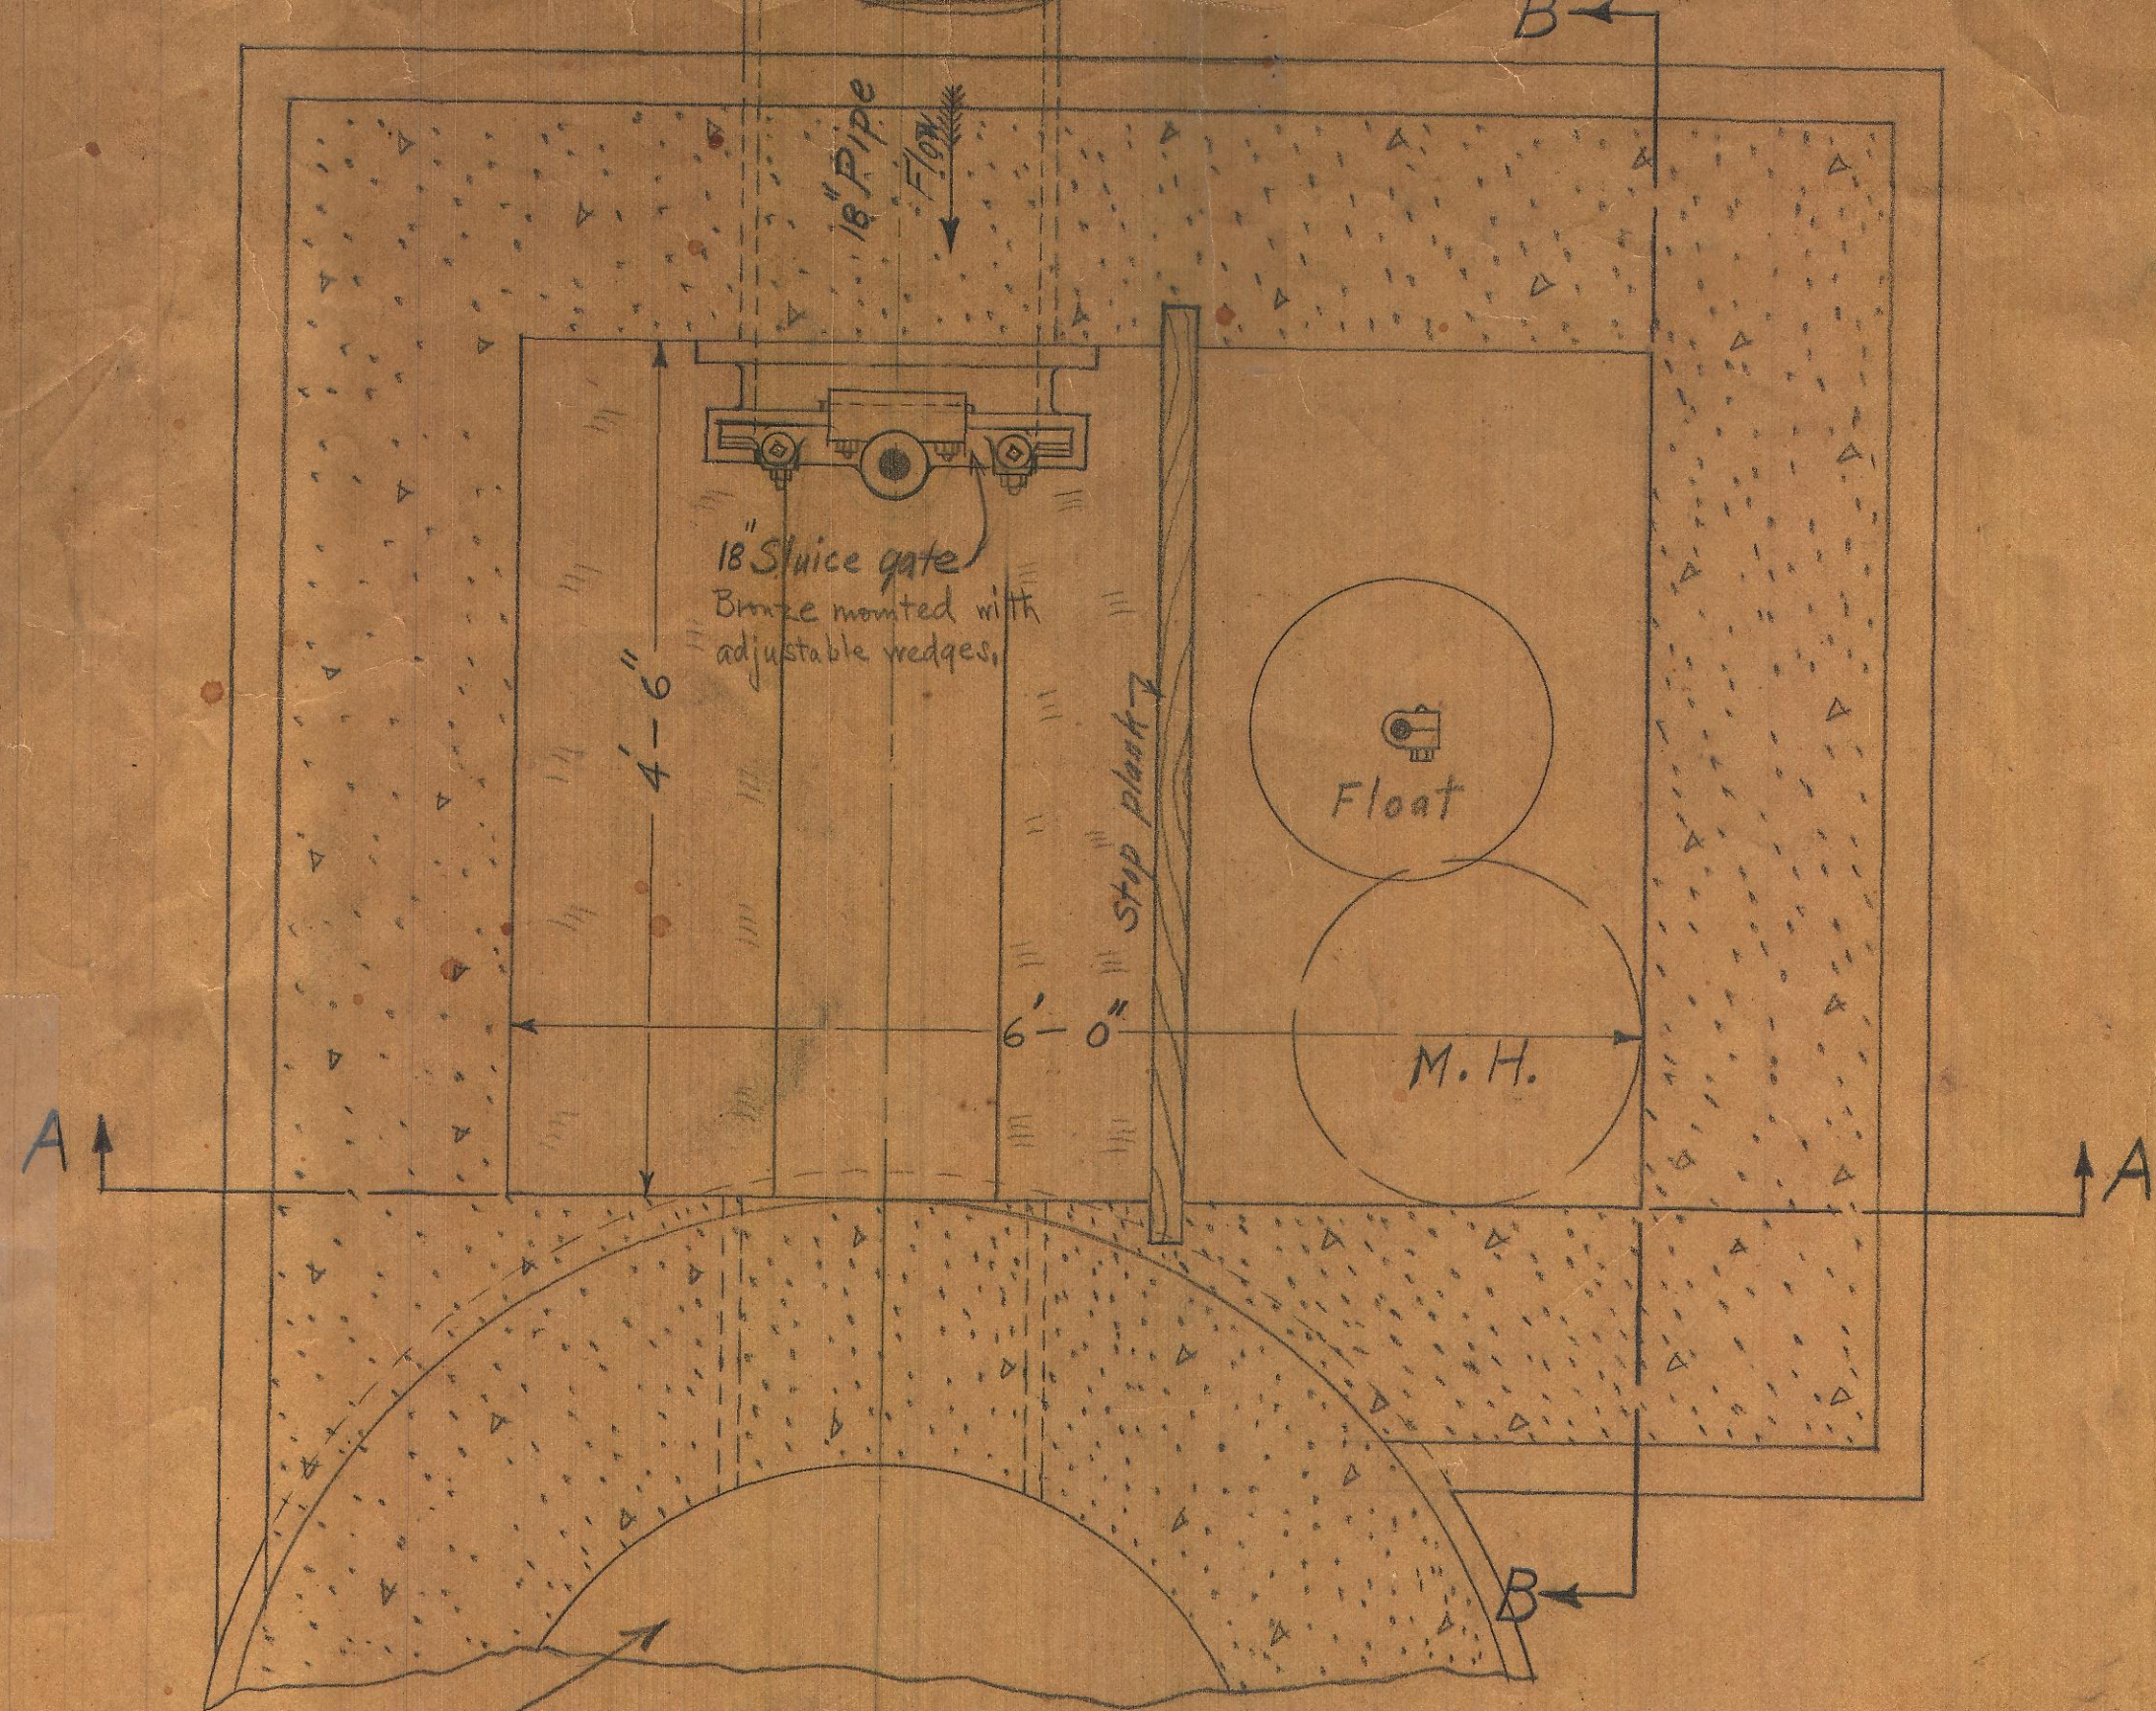


Existing M.H. Sectional Plan C-C.
Scale: 1"=1'-0"

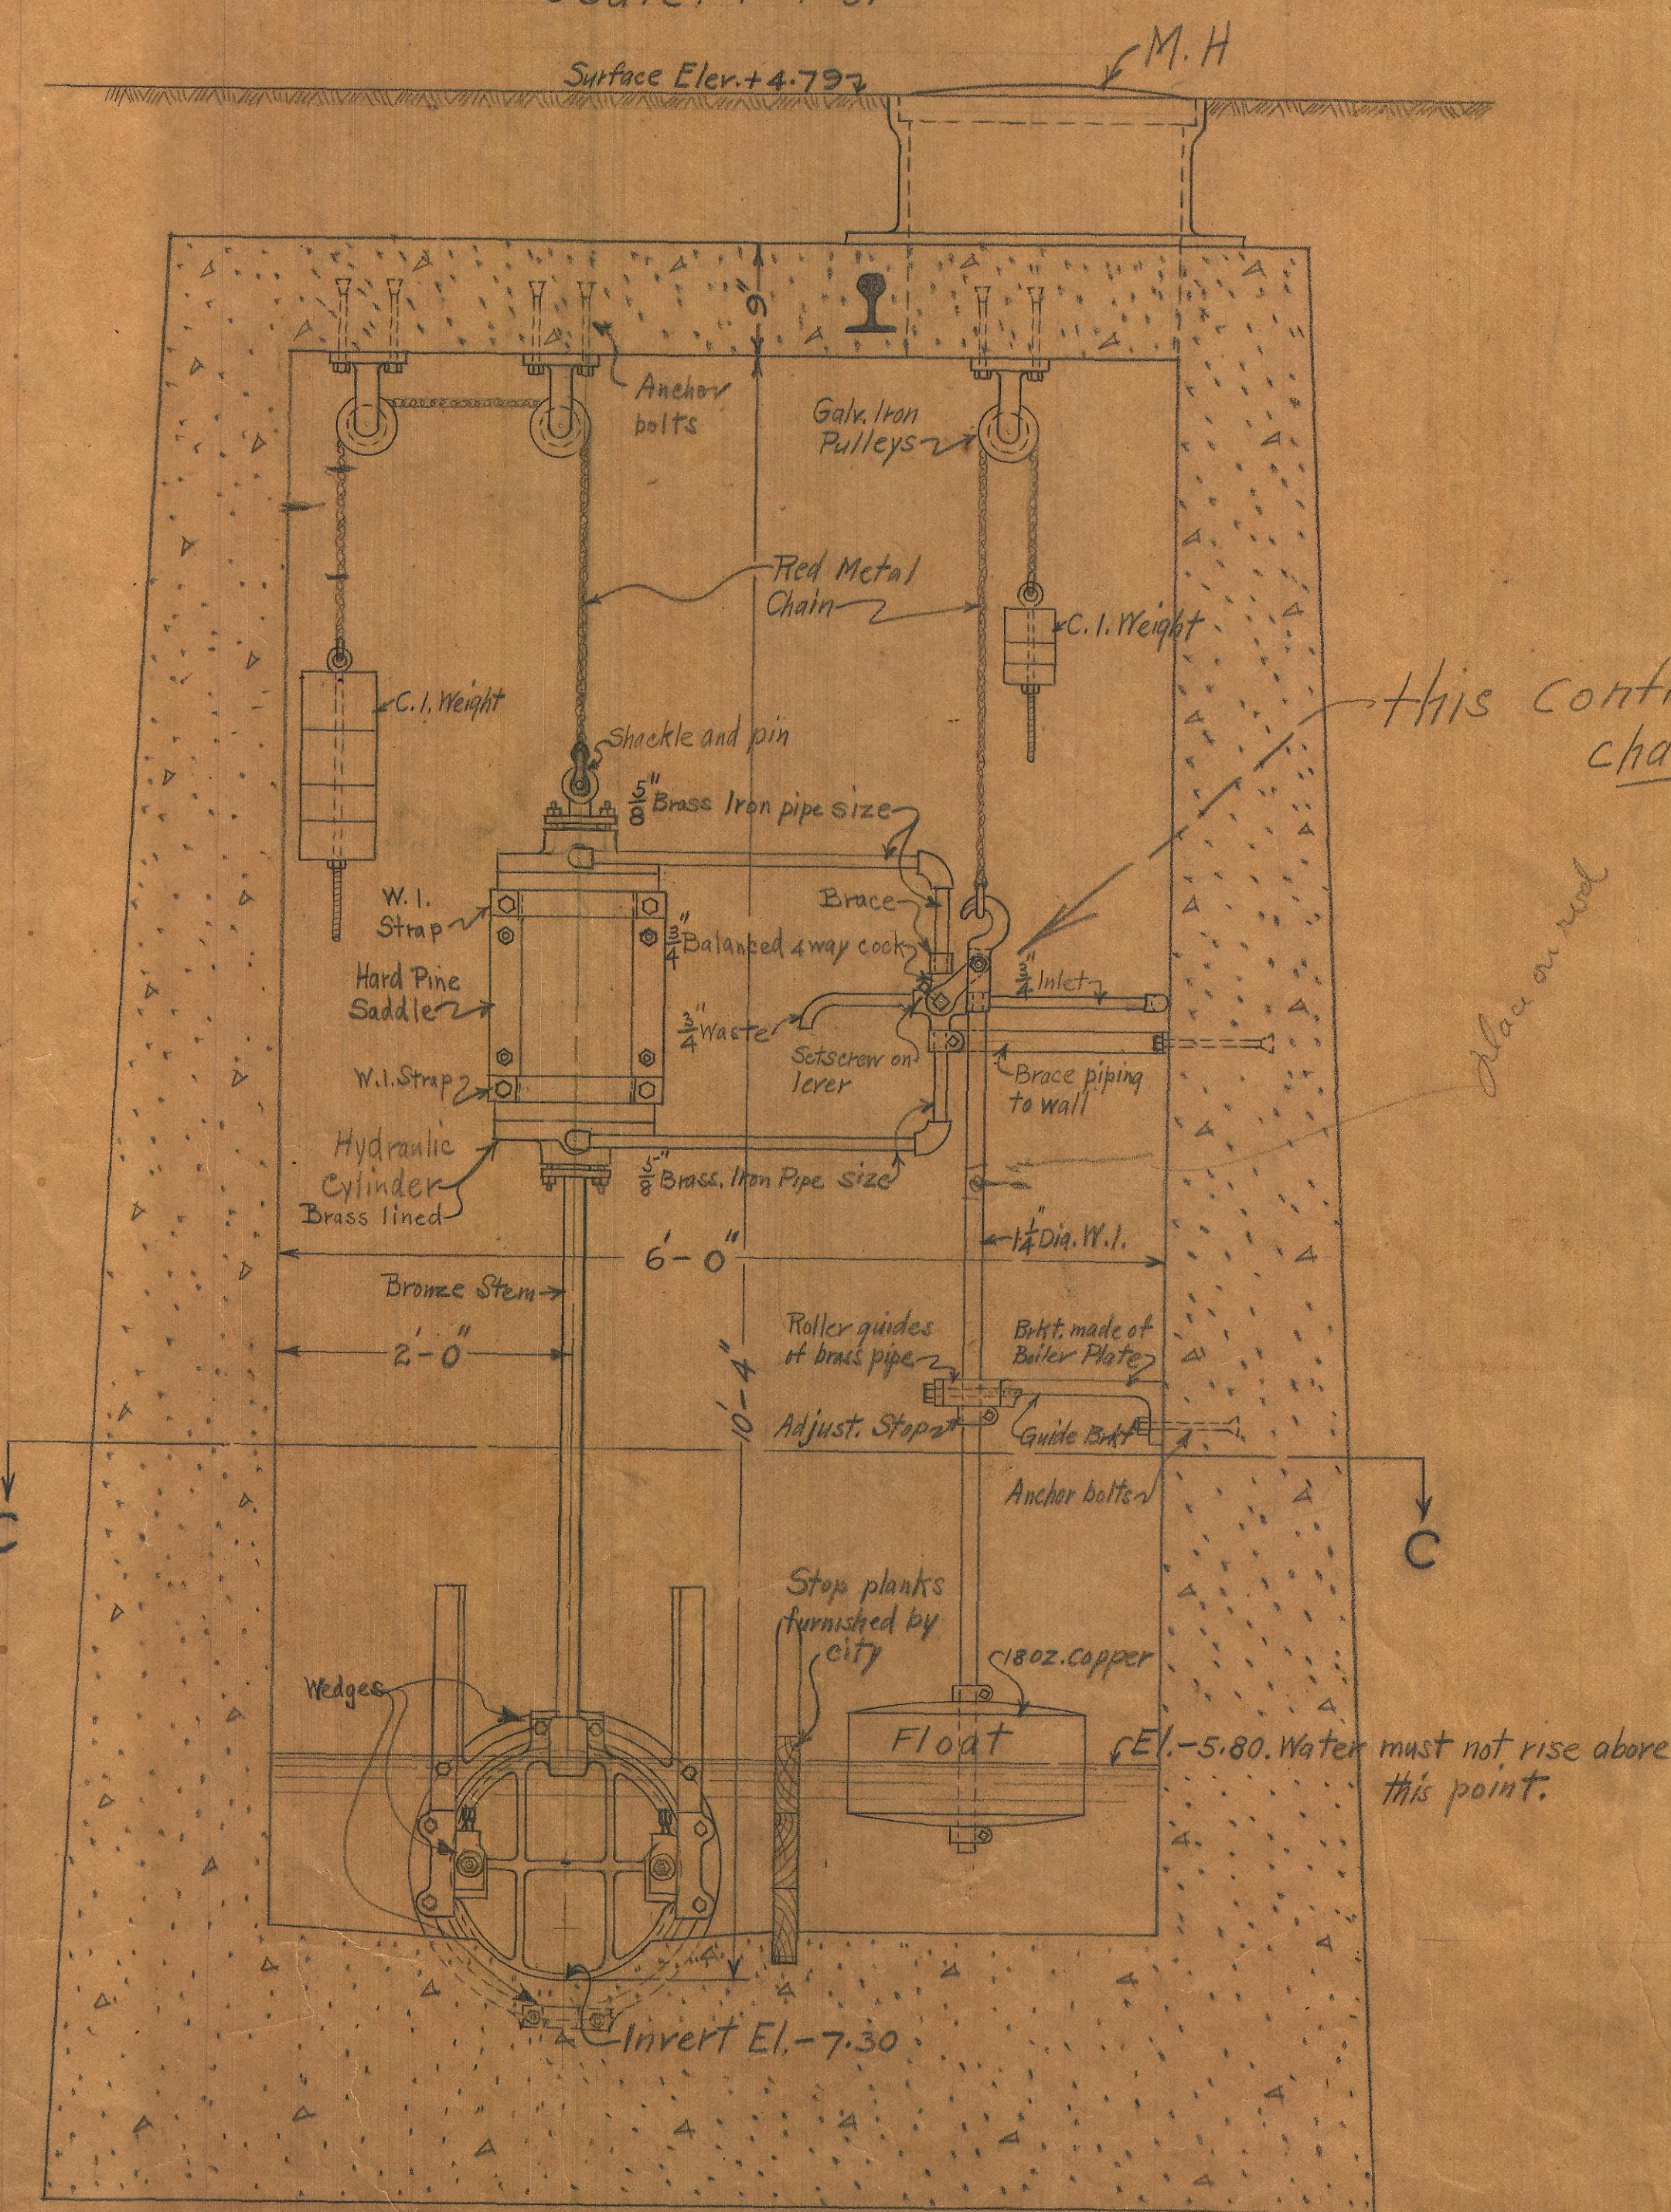

Sectional Elevation A-A.
Scale: 1"=1'-0"

Note: - Assembled and tested for cut off, counterweights etc, in shop, by contractor.
City will bring water supply into M.H. Contractor will connect same to cylinder etc.
Give H.P. saddle 2 coats of raw linseed oil.
Maximum pressure on back of gate = 3 lb per sq. inch.
Bronze mounted circular sluice gate = Coffin Valve Co's Fig. 84.

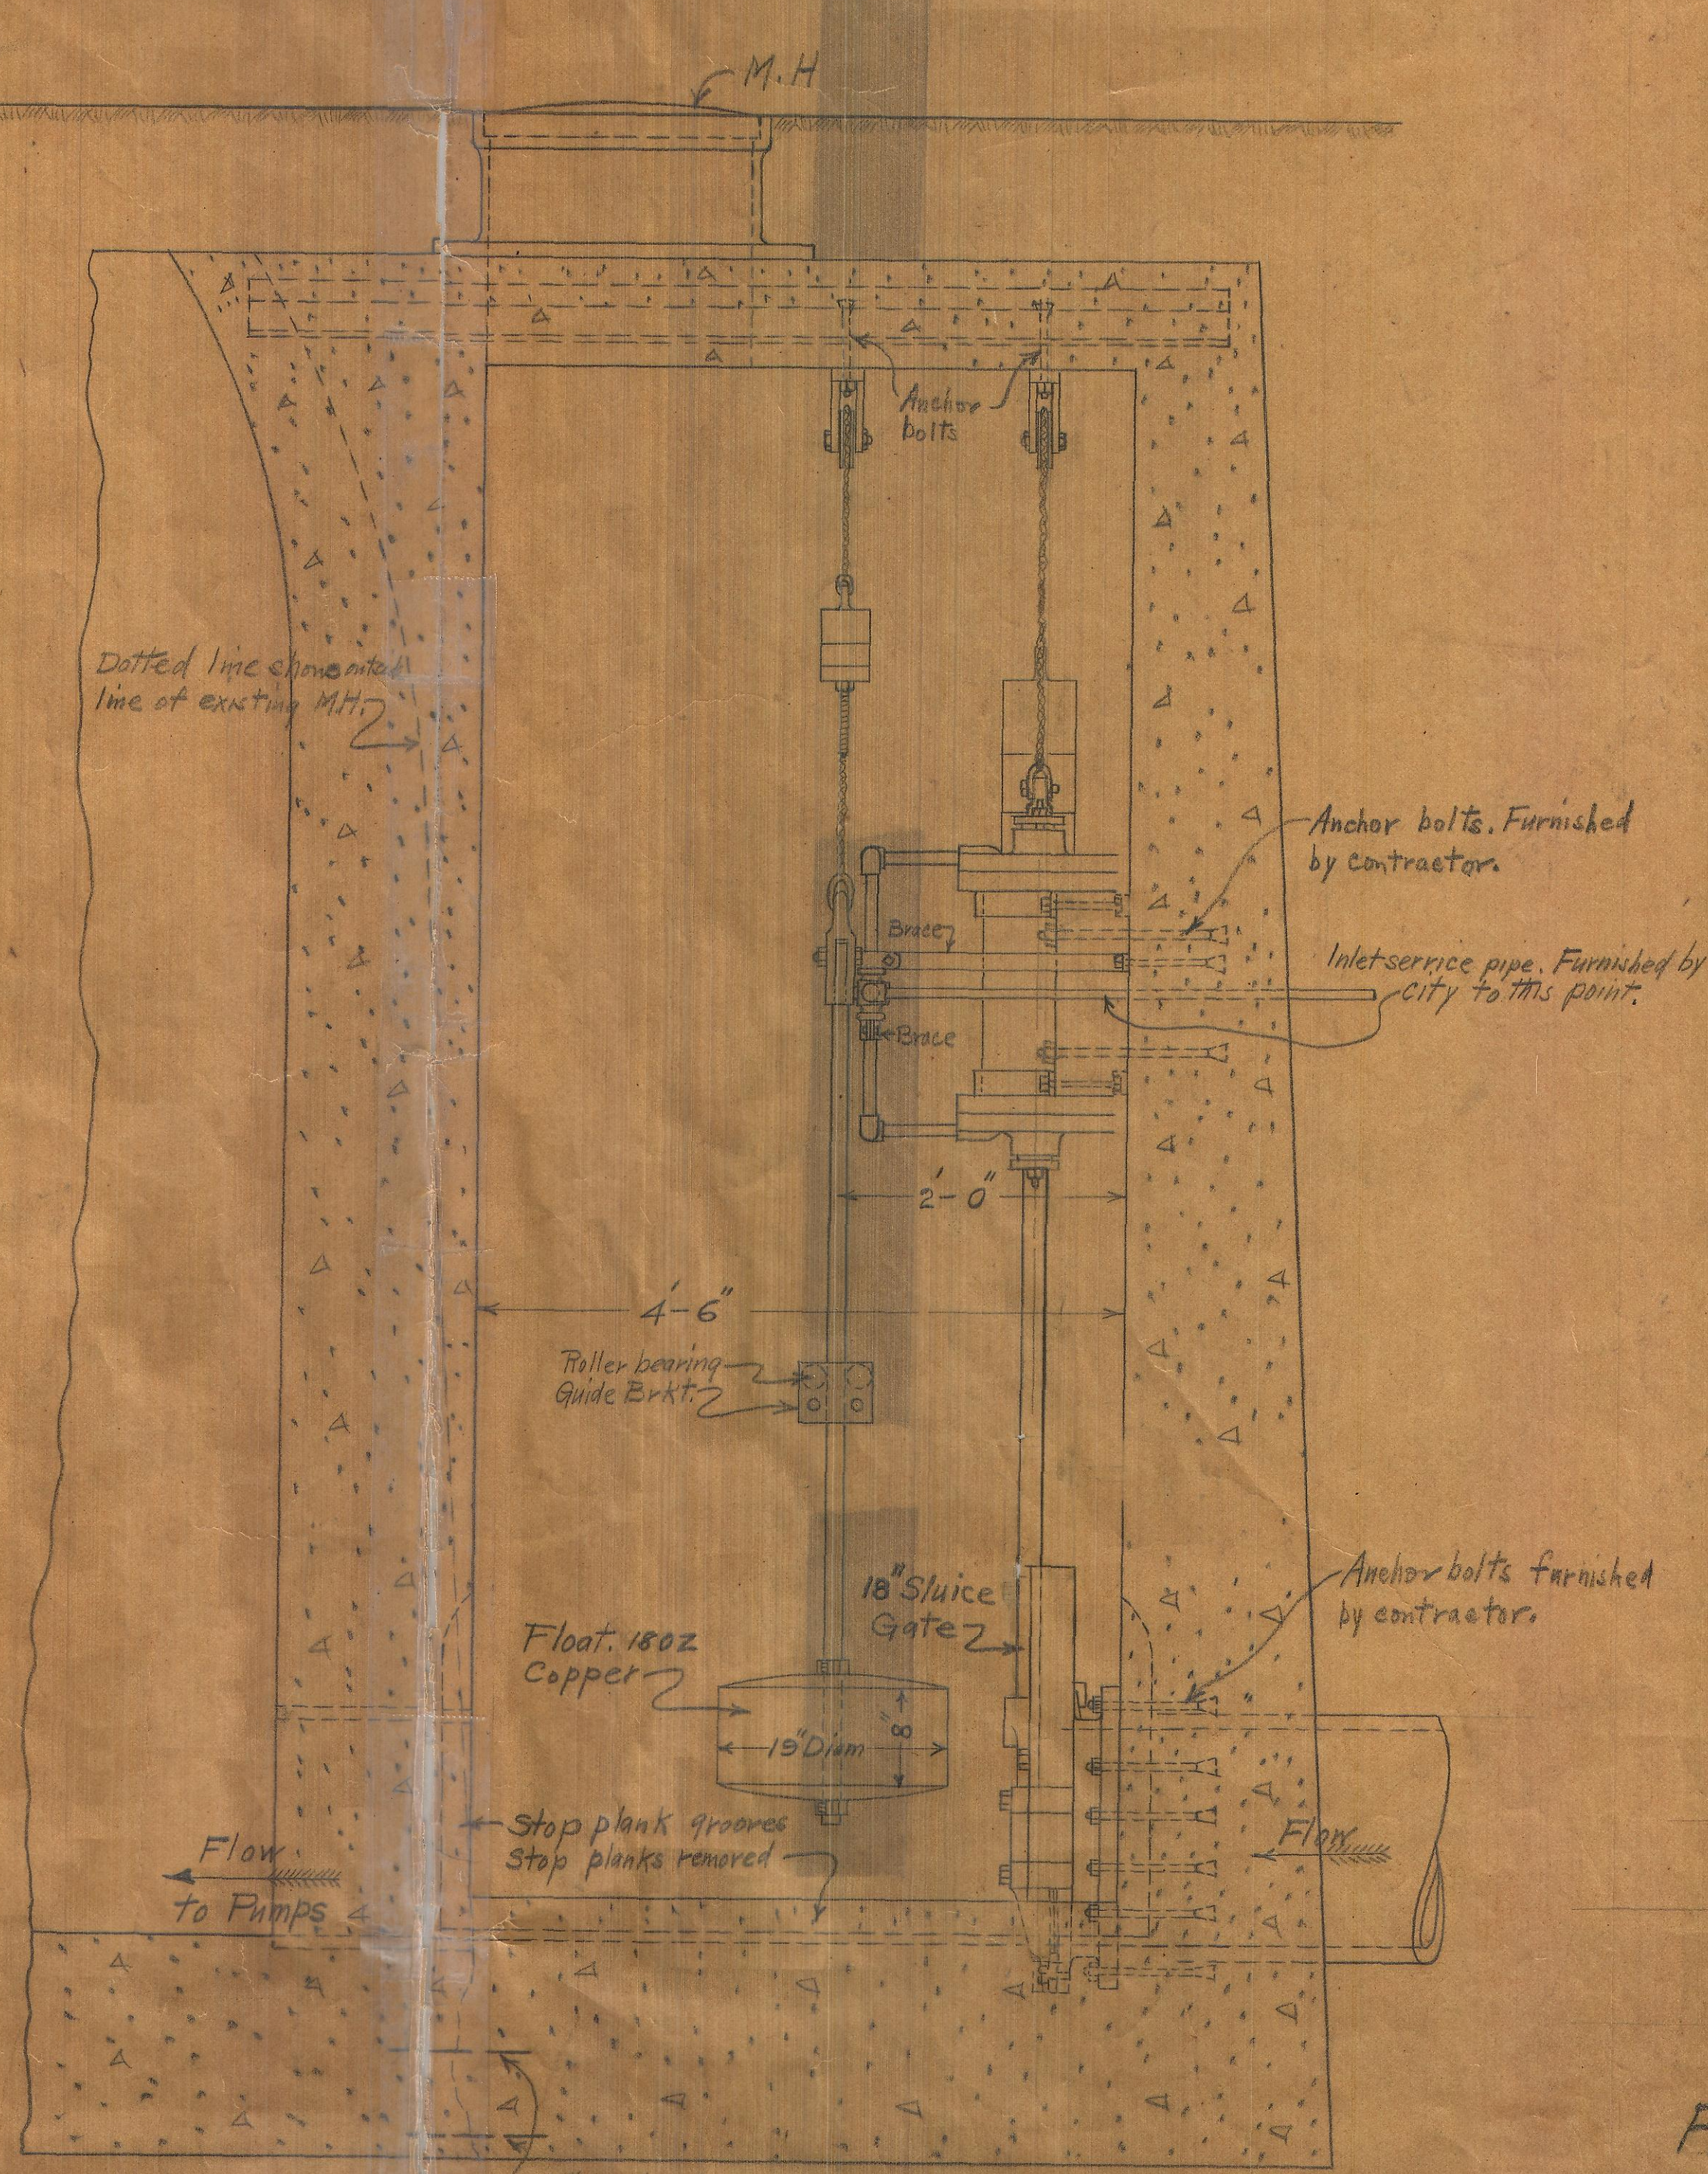

Sectional Elevation B-B.
Scale: 1"=1'-0"

City of New Bedford
Intercepting Sewer System.
Automatic Shut-off Gate
at
First and Howland Sts. Pump Station.

February, 1915.