
2289

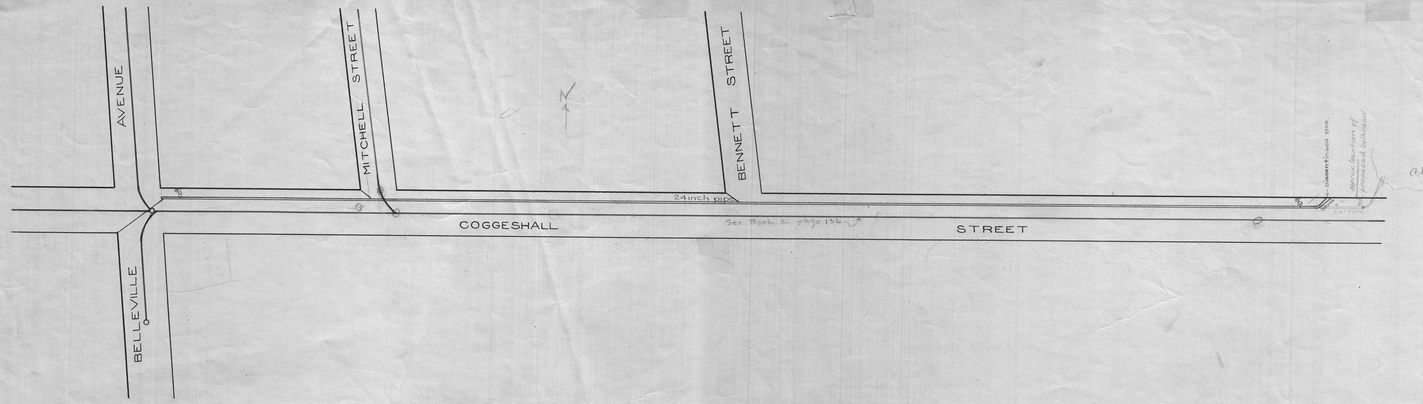

COGGESHALL ST. SEWER

FROM BELLEVILLE AVENUE EAST 1293.1 FEET

This sewer is constructed for surface water

LENGTH

1291.1 ft. of 24" glazed pipe and 20 feet of stone

SCALE

Horizontal, 1 inch = 60 ft. Vertical, 1 inch = 6 feet

Ordered	Nov. 27, 1900
Construction Commenced	Jan. 2, 1900
Average Depth	6.73 feet
Ledge Excavated	None
Cost	$ 3148.19
Amount Assessed	
Foreman	William Leary

Field-book 107 pages 56-57

William F. Williams
CITY ENGINEER.

STONE OUTLET DISCONTINUED

SURFACE DRAIN EXTENDED EAST

LENGTH

68 feet of glazed pipe 24 inches in diameter.


SCALE

Horizontal 1 inch = 60 feet Vertical 1 inch = 6 ft.

Ordered	April 22 1908
Construction Commenced	June 22 1908
Average Cut	8.55 feet
Ledge Excavated	None
Cost	$ 269.18
Amount Assessed	$ 0.00
Foreman	John Quinn

Field book 248 page 3

CITY ENGINEER

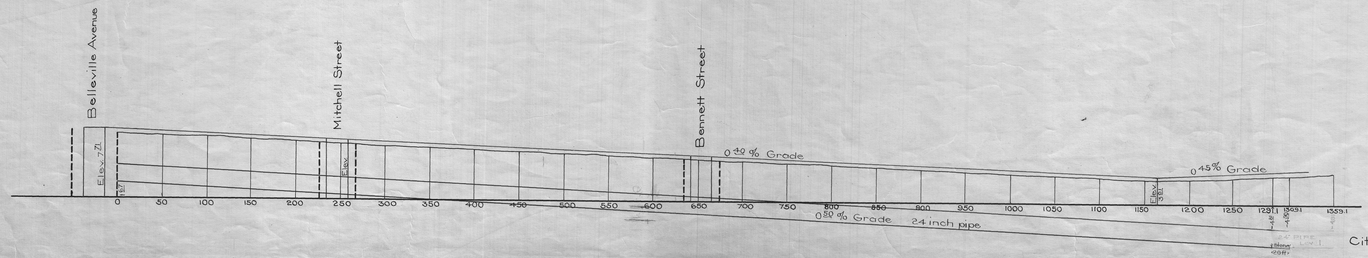

6822