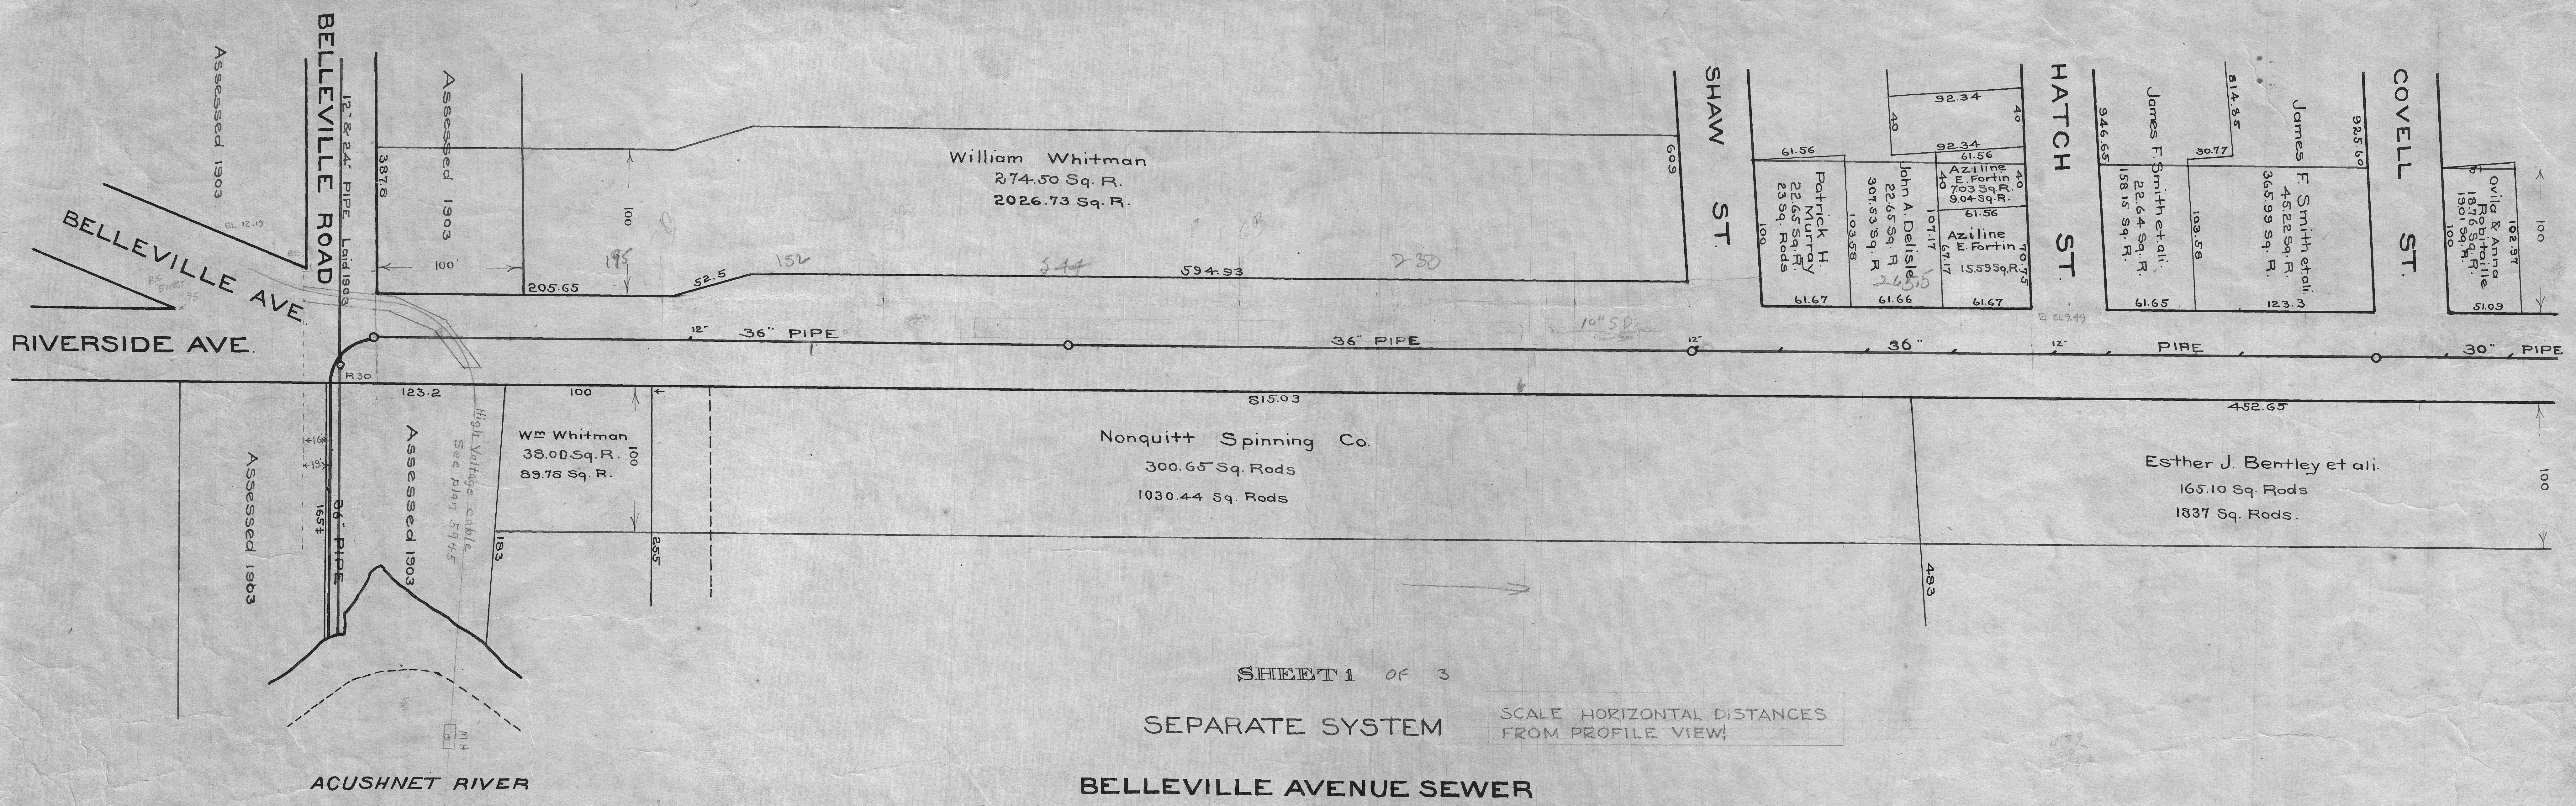

SHEET 1 OF 3

SEPARATE SYSTEM

SCALE HORIZONTAL DISTANCES
FROM PROFILE VIEW!

BELLEVILLE AVENUE SEWER

FROM THE RIVER AT BELLEVILLE ROAD TO MAIN STREET

LENGTH

1547.0 feet of glazed pipe 36 inches in diameter
1169.5 feet of glazed pipe 30 inches in diameter
1000.0 feet of glazed pipe 24 inches in diameter
1013.8 feet of glazed pipe 18 inches in diameter

SCALE

Horizontal 1 inch = 60 feet Vertical 1 inch = 6 ft.

Ordered	Sept. 3. 1907
Construction Commenced	Nov. 15 1907
Average Cut	feet
Ledge Excavated	Cu Yds.
Cost	$20,685.99
Amount Assessed	$ 8869.31
Foreman	Wm Smith

Field book 247, page 18

William F. Williams
CITY ENGINEER.