MAIN Extension:

expires 11-6-20.

SERVICE 34063 ONLY.

NEW BEDFORD WATER WORKS

APPLICATION FOR SERVICE AND METER

NEW BEDFORD 11-6-19

I HEREBY ACKNOWLEDGE the receipt of a copy of the Regulations prescribed in the Ordinance of the City, for the use of Water, and I request that the water may be furnished through a

Northerly 8 inch meter at Lambeth St from present terminus for Lambeth. to Edgewood St 450 ft / Edgewood, St Northerly a 70 ft

at such rates as may from time to time be established by the City.

I hereby agree to pay promptly the bill for the Service pipe laid down for my premises, and to pay all dues for water, and I agree to conform to the said Regulations and to all provisions of the Water Ordinances, until written notice is given by me or my agent to cut off the supply.

P. 125A.

NO service connection permits will be issued until main has been tested. As built has been submitted & approved.

x Rosa Mang

DAM Development
70 Lambeth St
NBMA 02745.

TELEPHONE

Service laid Contractor: RJ CANESSA Size and kind of pipe

From St.

Turned on Meter Set

Reading Total footage = 520 Location $2,080

Building rates Paid + + 450 permit fee

Cost of Service $450 At Main Cut cost $ = 1,800 Paid = $2,530 chk # 845

31-727 70 ft a 4 per ft = $280.00 =

N X N LINE BTARKILN HILL RD

N X EXIST GV

E X W LINE LAMBETH ST

8 " DUCTILE MAIN

INSPECTED BY PERCY REYNOLDS

ROBERT CANESSA CONTRACTOR

MISCELLANEOUS PAYMENT RECPT#: 2555771
City of New Bedford
133 William St.
New Bedford MA 02740

DATE: 12/10/19 TIME: 12:27
CLERK: a450mmb DEPT:
CUSTOMER#: 0

COMMENT:

CHG: DPIEXT DPI WATER MAIN 2530.00

REVENUE:
1 55006000 439020 2530.00
   OTH -Departmental Fees
CASH:
   TW05 101009 2530.00
   Cash Treasurer Dep W

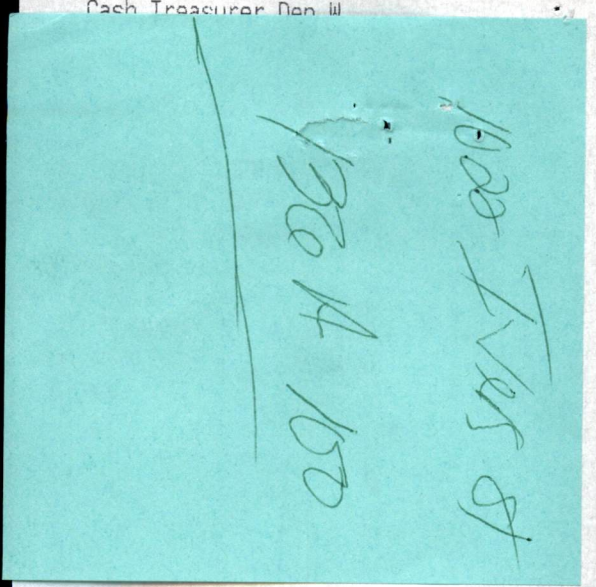

MISCELLANEOUS PAYMENT RECPT#: 2555771
City of New Bedford
133 William St.
New Bedford MA 02740

DATE: 12/10/19 TIME: 12:27
CLERK: a450mmb DEPT:
CUSTOMER#: 0

COMMENT:

CHG: DPIEXT DPI WATER MAIN 2530.00

REVENUE:
1 55006000 439020 2530.00
OTH -Departmental Fees
CASH:
TW05 101009 2530.00
Cash Treasurer Dep W

AMOUNT PAID: 2530.00

PAID BY: DPM DEVELOPMENT
PAYMENT METH: CHECK
MR8245
REFERENCE:

AMT TENDERED: 2530.00
AMT APPLIED: 2530.00
CHANGE: .00

LOCUS MAP
NOT TO SCALE

NOTES

1. CONTRACTOR IS TO RESTRAIN ALL JOINTS ON THE PROPOSED WATER MAIN.
2. CONTRACTOR IS TO GLUE ALL SEWER PIPES AND FITTINGS.
3. AN AS BUILT PLAN OF THE SEWER AND WATER INSTALLATION IS TO BE SUBMITTED TO D.P.I. BEFORE SERVICE CONNECTION PERMITS CAN BE ISSUED.

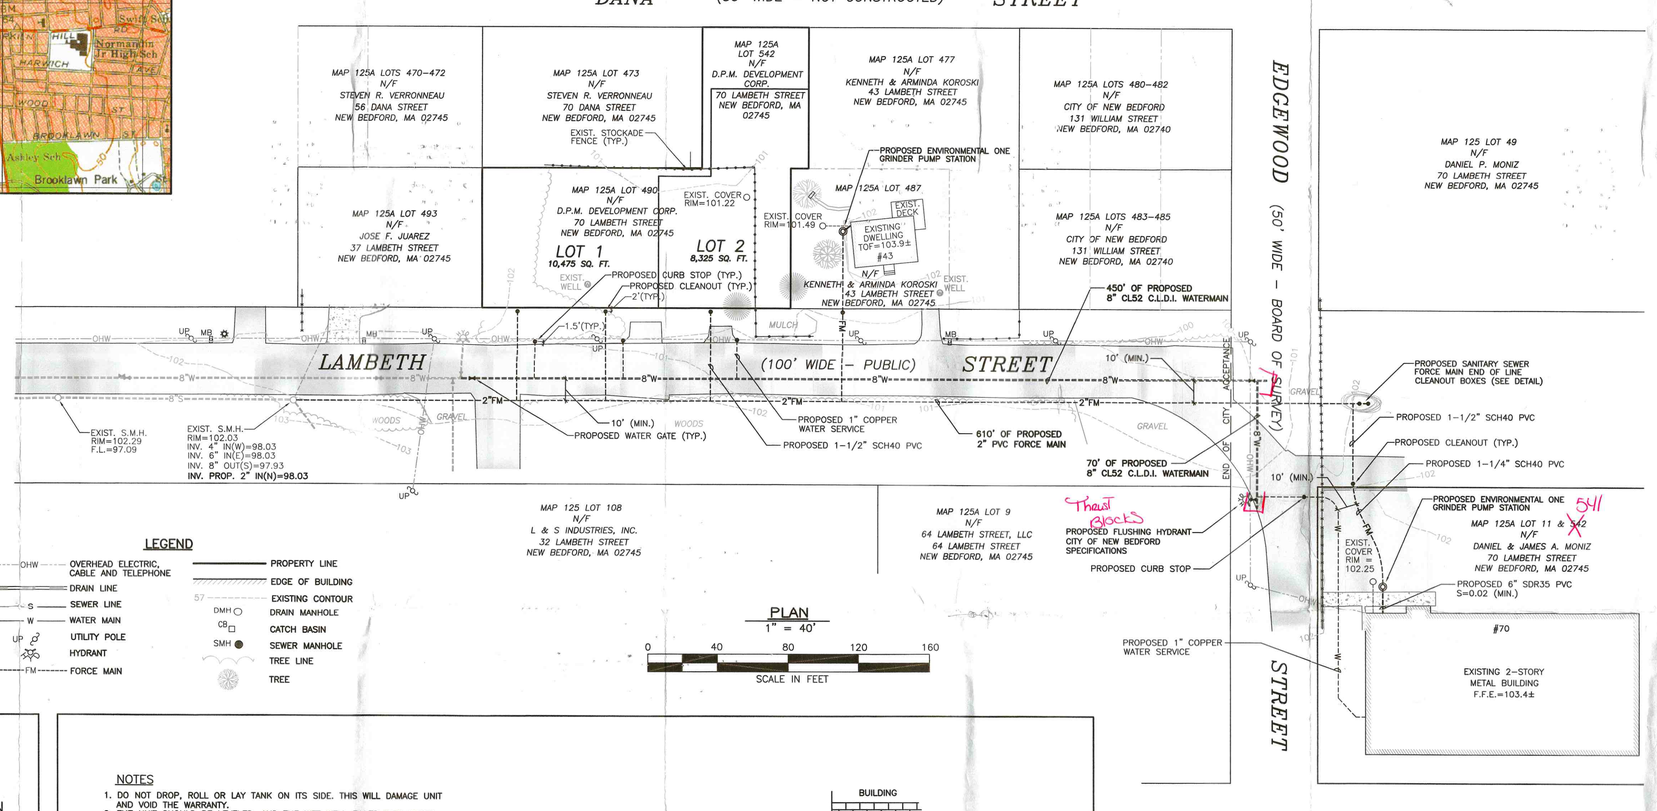

LEGEND

- OHW — OVERHEAD ELECTRIC, CABLE AND TELEPHONE
- DRAIN LINE
- S — SEWER LINE
- W — WATER MAIN
- UP — UTILITY POLE
- HYDRANT
- FM — FORCE MAIN
- PROPERTY LINE
- EDGE OF BUILDING
- 57 — EXISTING CONTOUR
- DMH — DRAIN MANHOLE
- CB — CATCH BASIN
- SMH — SEWER MANHOLE
- TREE LINE
- TREE

PLAN
1" = 40'

0 40 80 120 160
SCALE IN FEET

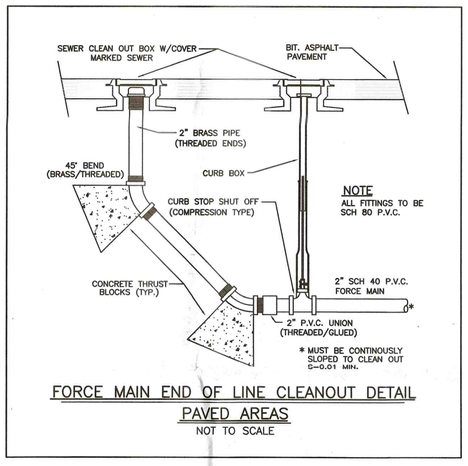

NOTE
ALL FITTINGS TO BE SCH 80 P.V.C.

FORCE MAIN END OF LINE CLEANOUT DETAIL
PAVED AREAS
NOT TO SCALE

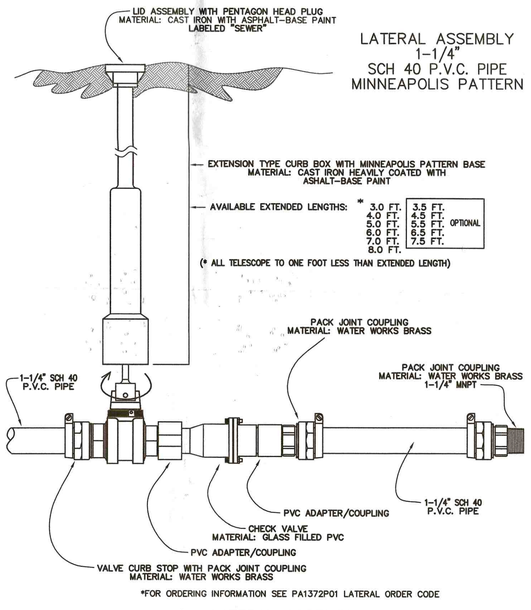

LATERAL ASSEMBLY
1–1/4"
SCH 40 P.V.C. PIPE
MINNEAPOLIS PATTERN

*FOR ORDERING INFORMATION SEE PA1372P01 LATERAL ORDER CODE

LATERAL ASSEMBLY
NOT TO SCALE

NOTES

1. DO NOT DROP, ROLL OR LAY TANK ON ITS SIDE. THIS WILL DAMAGE UNIT AND VOID THE WARRANTY.
2. THE UNIT SHOULD BE LEVELED, AND THE WET WELL FILLED WITH WATER, TO THE BOTTOM OF THE INLET, TO HELP PREVENT THE UNIT FROM SHIFTING WHILE THE CONCRETE IS BEING POURED.
3. "OATLEY" (DARK GREEN LABLE) ALL WEATHER CEMENT FOR PVC PIPE AND FITTINGS IS TO BE USED, EXCEEDS ASTM D–2564.
4. ELECTRICAL WIRING PER STATE AND LOCAL CODES.
5. 1 1/4" DIAMETER SCHEDULE 40 PRESSURE PIPE MUST HAVE MINIMUM PRESSURE RATING OF 370 PSI WITH A CELL CLASS OF 12454–B.

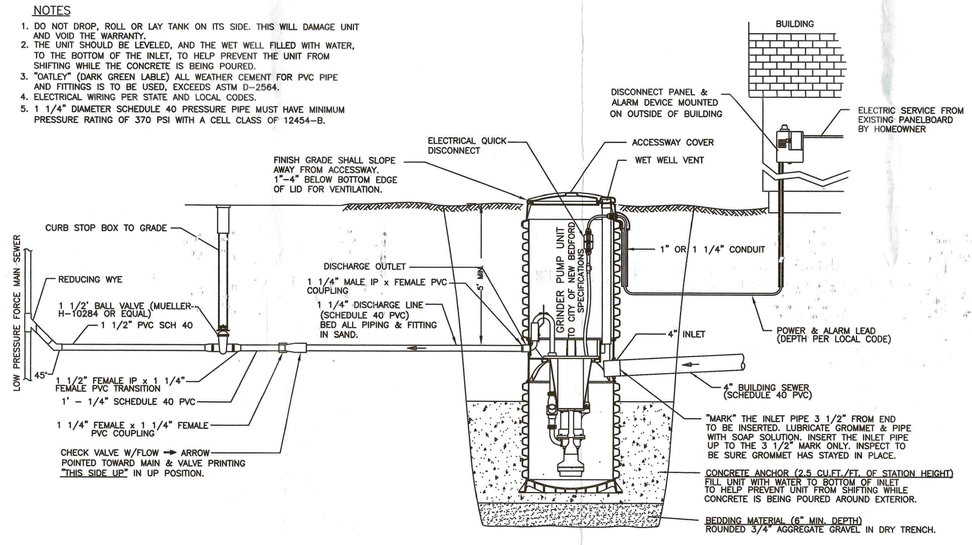

GRINDER PUMP DETAIL
NOT TO SCALE

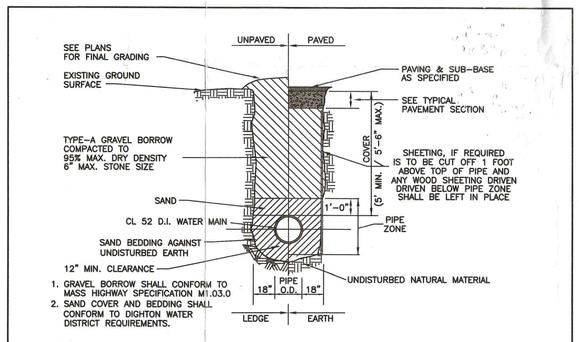

1. GRAVEL BORROW SHALL CONFORM TO MASS HIGHWAY SPECIFICATION M1.03.0
2. SAND COVER AND BEDDING SHALL CONFORM TO DIGHTON WATER DISTRICT REQUIREMENTS.

TYPICAL WATER TRENCH DETAIL
NOT TO SCALE

No.	Date	Revision Description	Chkd. by	Apprvd. by
1	7–22–19	PER D.P.I. COMMENTS	SDG	SDG
2	9–20–19	PER D.P.I. COMMENTS	SDG	SDG
3	10–24–19	PER D.P.I. COMMENTS	SDG	SDG
4	11–4–19	PER D.P.I. COMMENTS	SDG	SDG

scale: 1" = 40'
date: 6–4–19
drawn: JPT
checked: SML
approved: SDG
sheet 1 of 1
drawing number: SWEXT–1

project: ASSESSORS PLAT 125A LOTS 490, 487 & 11
LAMBETH STREET
NEW BEDFORD, MASSACHUSETTS
549
owner: D.P.M. DEVELOPMENT, INC.
drawing title: SEWER AND WATER EXTENTION PLAN

SITEC, Inc.
449 Faunce Corner Road
Dartmouth, MA 02747
(508) 998–7215
FAX (508) 998–7554
SITEC
Civil and Environmental Engineering
Land Use Planning

Acad No. 18–7053_SEW EXT
Job No. 18–7053